


T.23 S. R. 3 W. W.M.

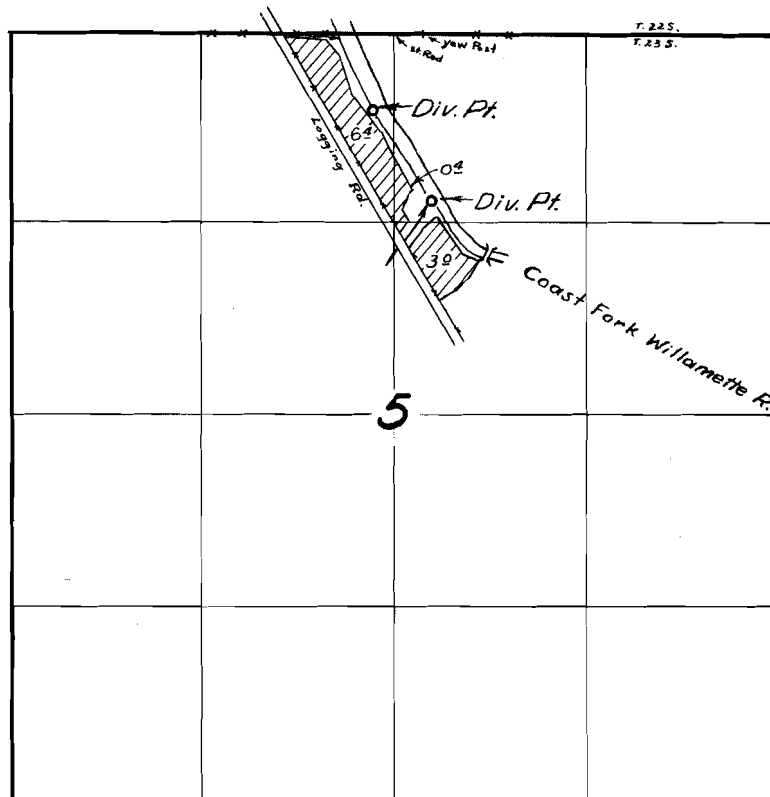

FINAL PROOF SURVEY
UNDER

Application No. *27822* Permit No. *21824*
IN NAME OF

Hollis & Carol Jean Real

Surveyed *April 10* 1957, by *Tr. Bish*