


T.22S.R.3 W.W.M.

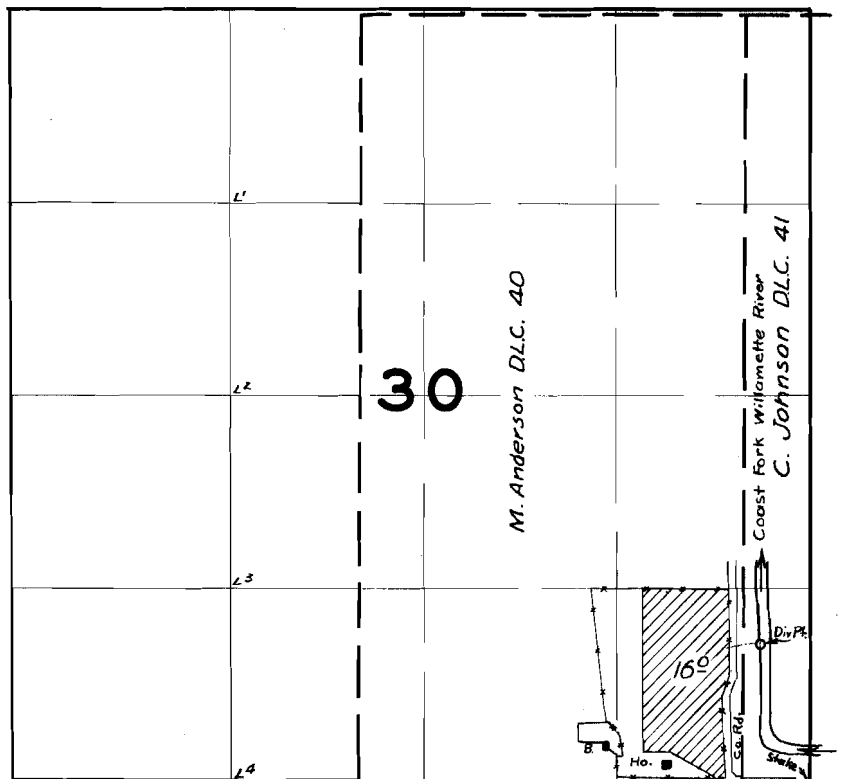

FINAL PROOF SURVEY
UNDER

Application No. 27727. Permit No. 21840.
IN NAME OF

Ronald L. & Buelah N. Weckert

Surveyed April 23 1957, by M. Bish