


T.20S. R.3 W.W.M.

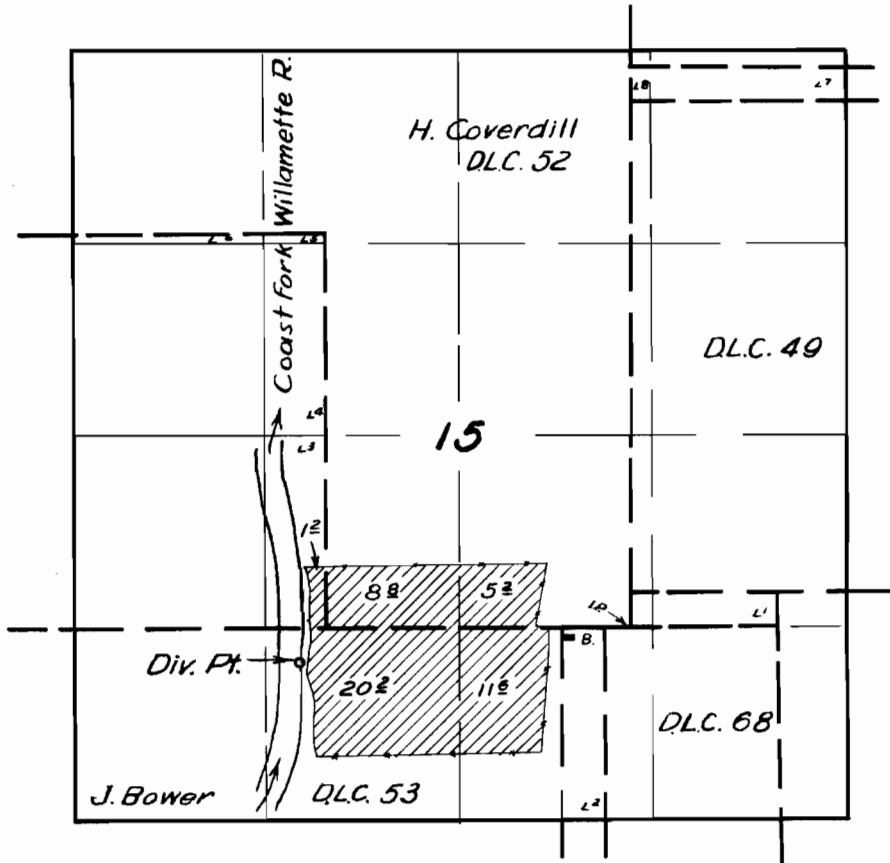

**FINAL PROOF SURVEY**

UNDER

Application No. 27894 Permit No. 21972

IN NAME OF

C. W. & E. C. Umleby

Surveyed April 12, 1957, by M. B. B. B.