


T. 10 S. R. 1 W. W. M.

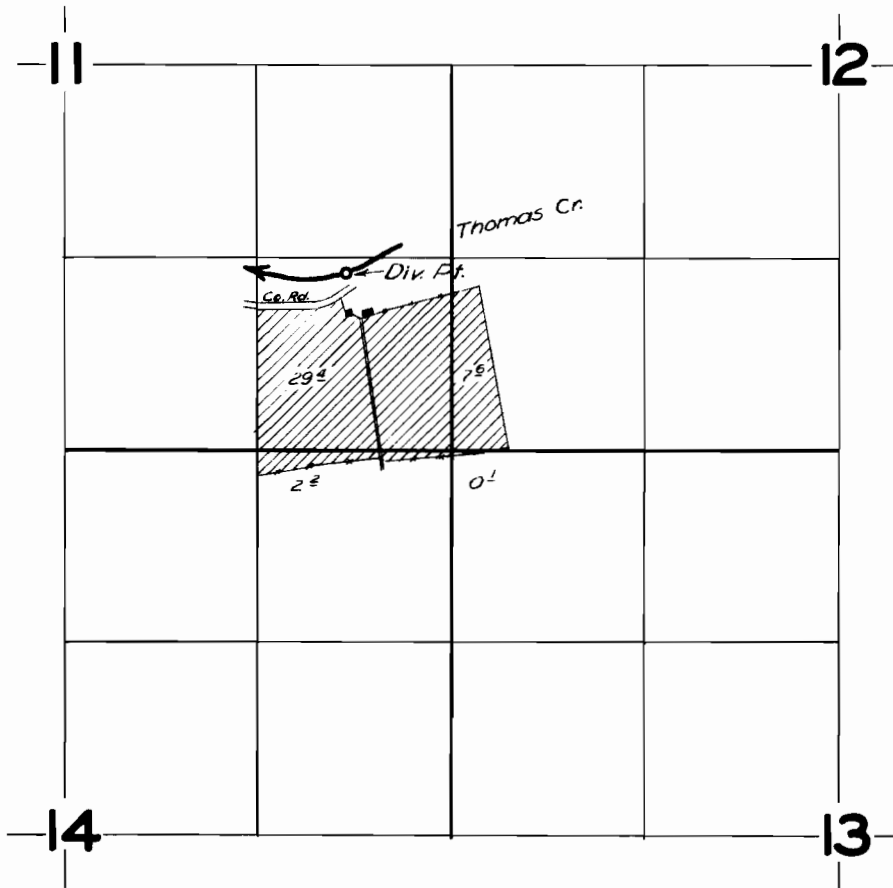

FINAL PROOF SURVEY

UNDER

Application No. 28484... Permit No. 22306...

IN NAME OF

E. L. Bilyeu

Surveyed *April 1, 1957*, by *Tom Bish*