


# T.I.O.S.R.I.E.W.M.

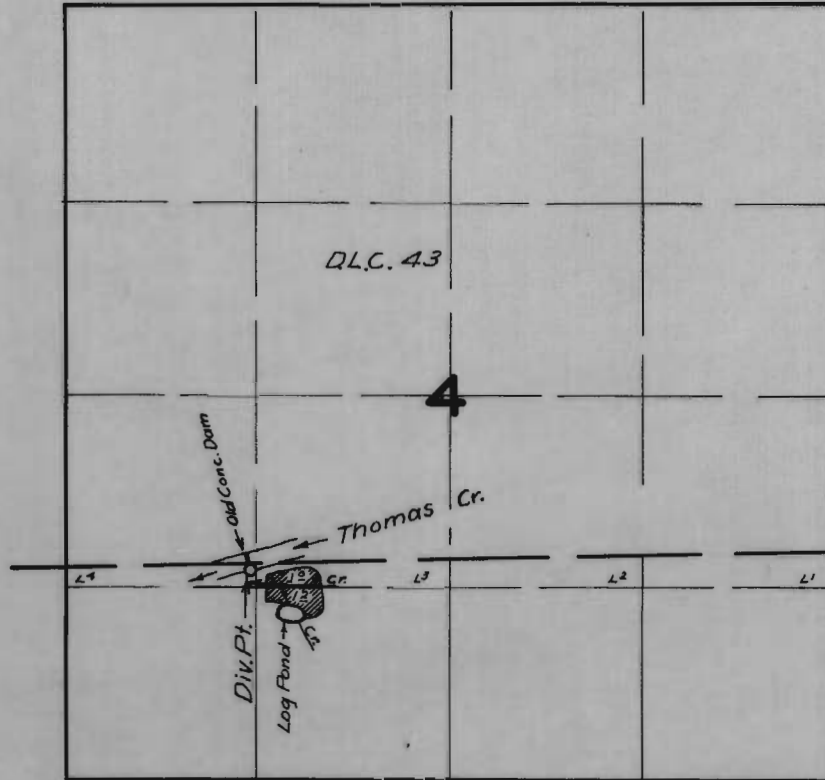

## FINAL PROOF SURVEY

UNDER

Application No. 28,516..... Permit No. 22,322.....

IN NAME OF

..... *Henry & Anna Heuberger* .....

Surveyed *April 2* 1957, by *Tom Bish*.....