


T. 7S. R. 2W. W.M.

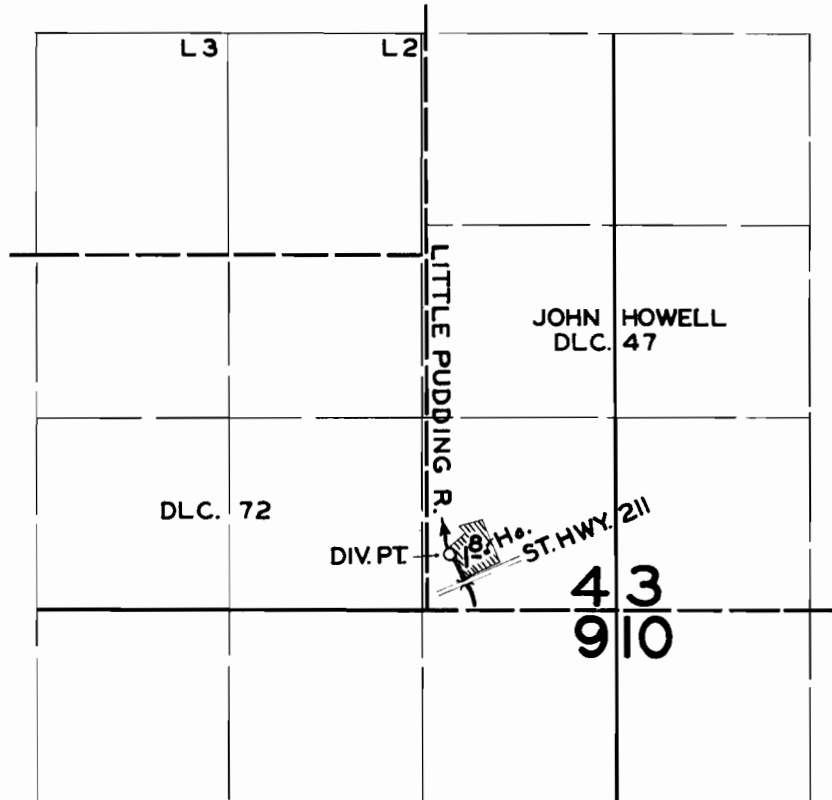

FINAL PROOF SURVEY

UNDER

Application No. 28334. Permit No. 22366.
IN NAME OF

HAROLD I. BEE SON

Surveyed MAR. 27. 1957., by C.O. BARTELS