


T.16S.R.6W.W.M.

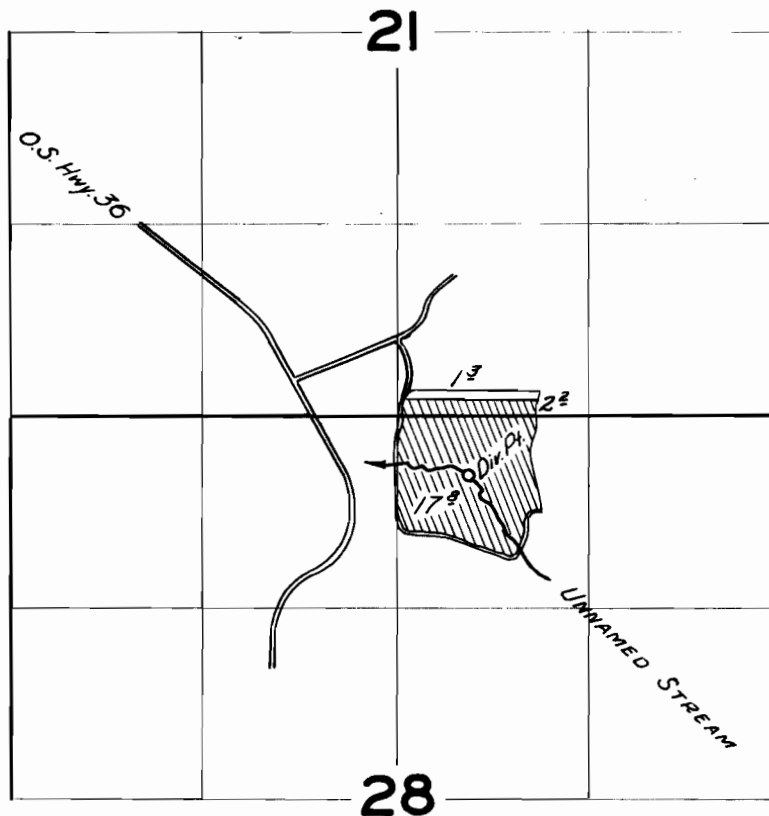

FINAL PROOF SURVEY  
UNDER

Application No. 28352 Permit No. 22454

IN NAME OF

OLIVER E. & LILLIAN B. SCHELL

Surveyed 12 April 1957, by C. A. Whitby