


T.17S.R.8W.W.M.

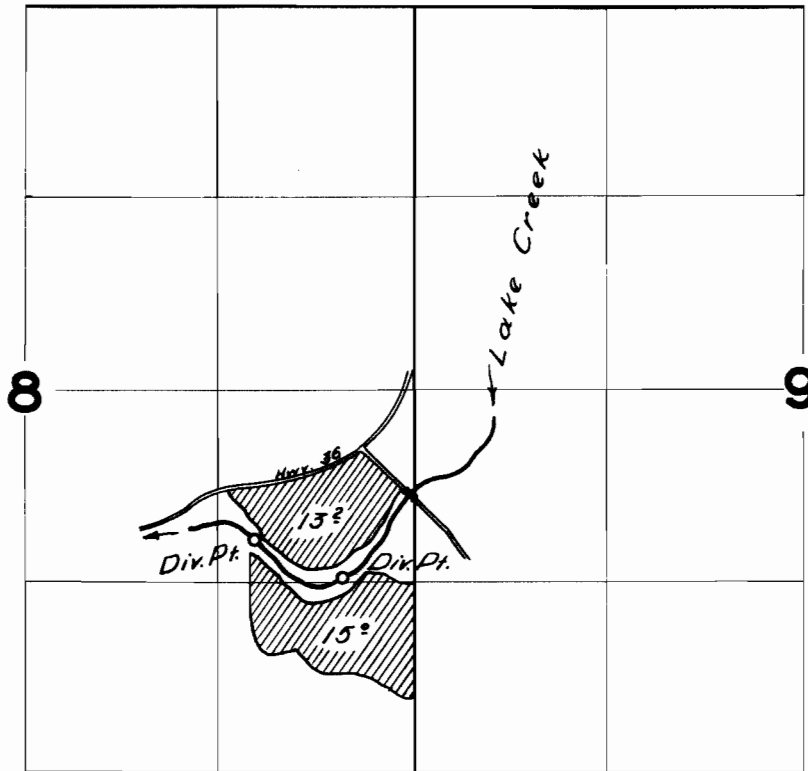

FINAL PROOF SURVEY

UNDER

Application No. 28654 Permit No. 22569

IN NAME OF

JOE WILCUT

Surveyed 22 May 1957, by *R. W. Wilcut*