


T. 9 S. R. 5 W. W. M.

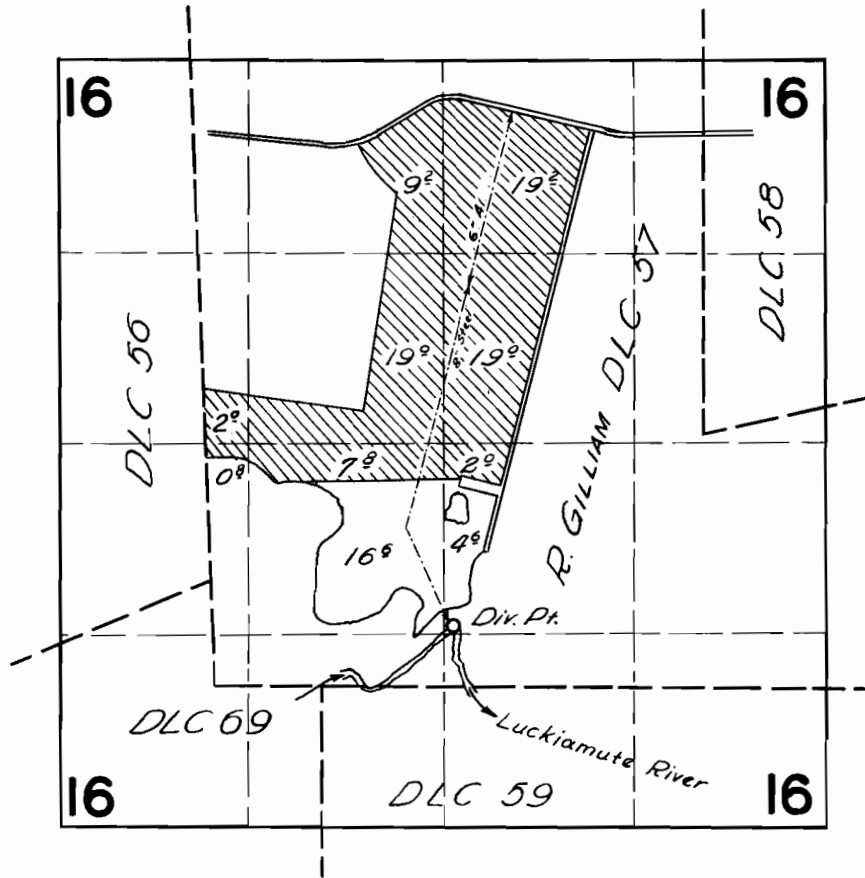

FINAL PROOF SURVEY

UNDER

Application No. 28882 Permit No. 22749

IN NAME OF

IVAN H. LOUGHARY

Surveyed 16 Aug 1956, by [Signature]