


T.10 S.R.1 W.W.M.

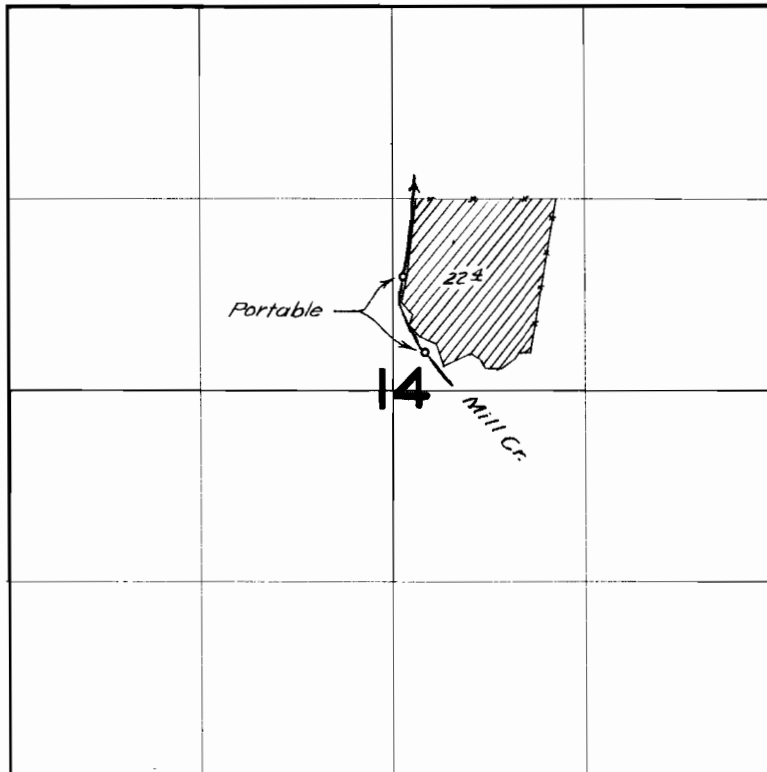

**FINAL PROOF SURVEY**  
UNDER

Application No. 28902 Permit No. 22753

IN NAME OF

*E.L. & Laura E. Bilyeu*

Surveyed *April 1, 1957*, by *Tom Bish*