


T.16S.R.5W.W.M.

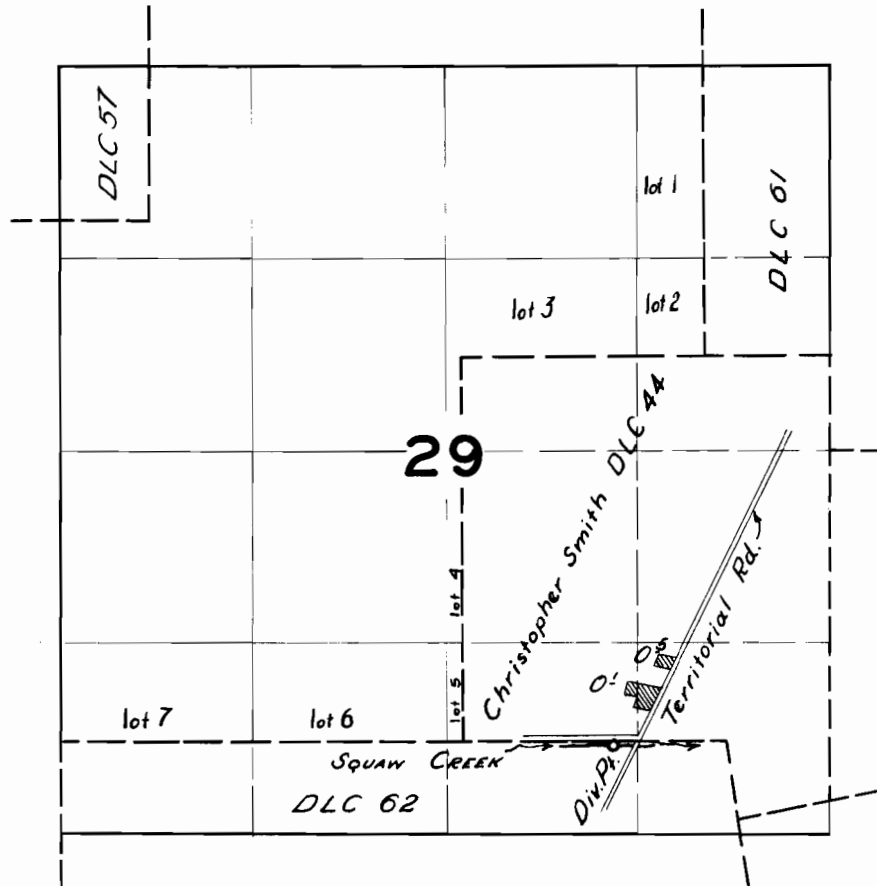

FINAL PROOF SURVEY  
UNDER

Application No. 29080 Permit No. 22868  
IN NAME OF

GEORGE GLEN MORRIS

Surveyed 10 April 1957, by R. Whitely