


T.17S.R.8W.W.M.

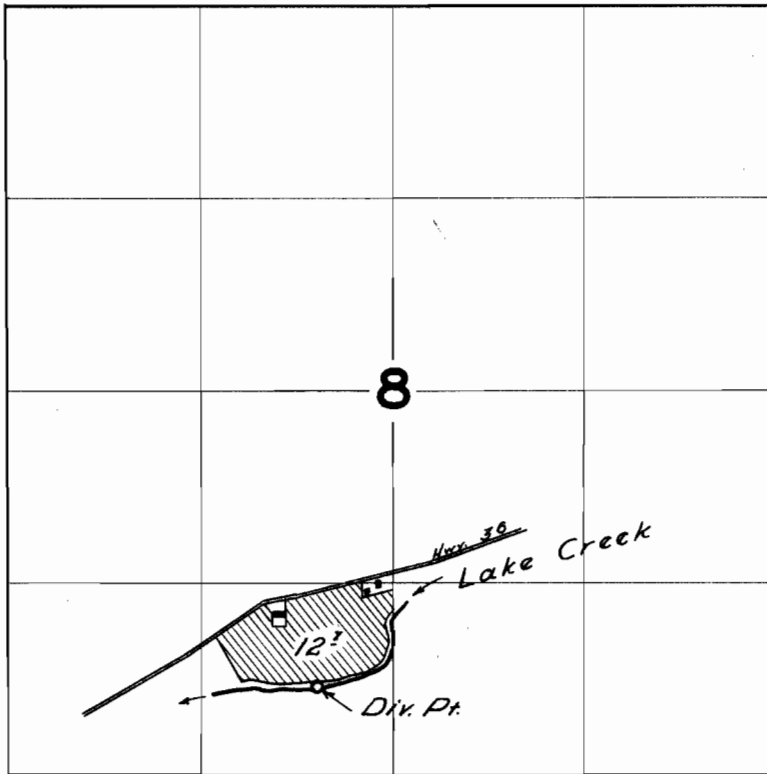

FINAL PROOF SURVEY
UNDER

Application No. 29201 Permit No. 22950

IN NAME OF

ADDISON W. SLACK

Surveyed 22 May 1957, by *Edwin Hilkey*