


T. 29S. R. 8W. W.M.

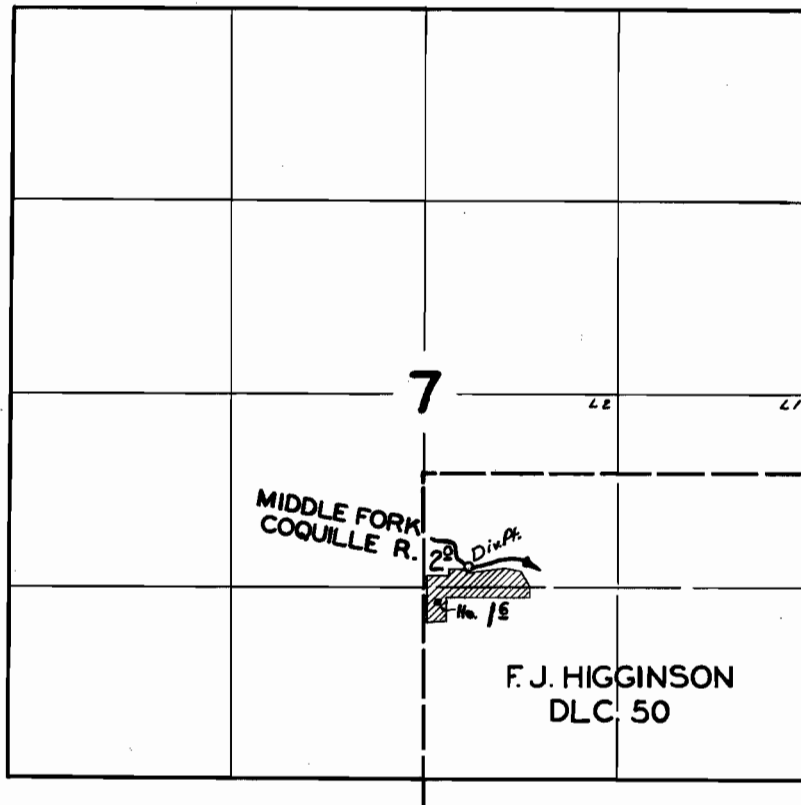

**FINAL PROOF SURVEY**

UNDER

Application No. 29203 Permit No. 23236

IN NAME OF

CARL DAHL

Surveyed 26 JUNE 1957, by C.O. BARTELS