


T.7S.R.4W.W.M.

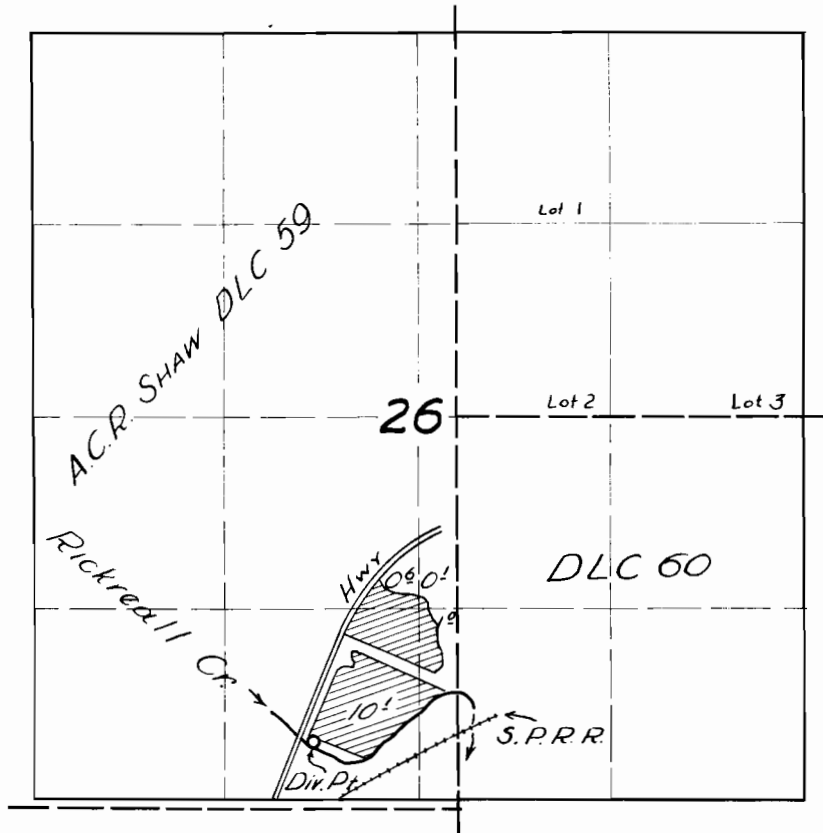

FINAL PROOF SURVEY
UNDER

Application No. 30266 Permit No. 23571
IN NAME OF

V. FRANK & MARIAN T. CHASTEEN

Surveyed 18 Mar. 1957, by *[Signature]*