


T.5S.R.2W.W.M.

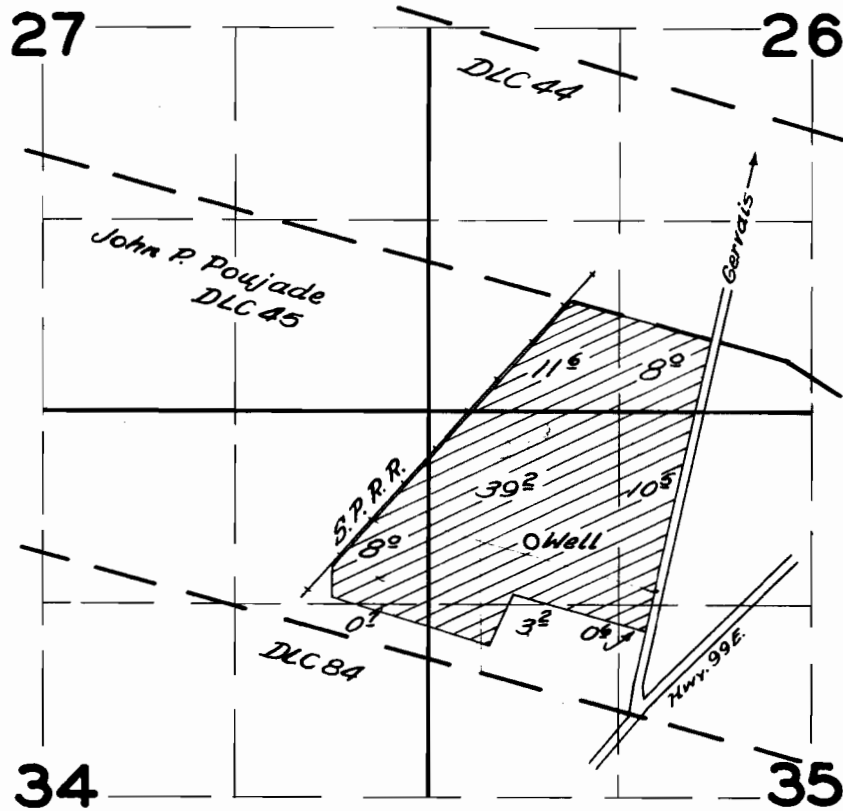

**FINAL PROOF SURVEY**  
UNDER

Application No. *G-110* Permit No. *6-8*  
IN NAME OF

*Zeno Schwab*

Surveyed *March 22 1957*, by *C.O. Burtch*