


# T.6S.R.2W.W.M.

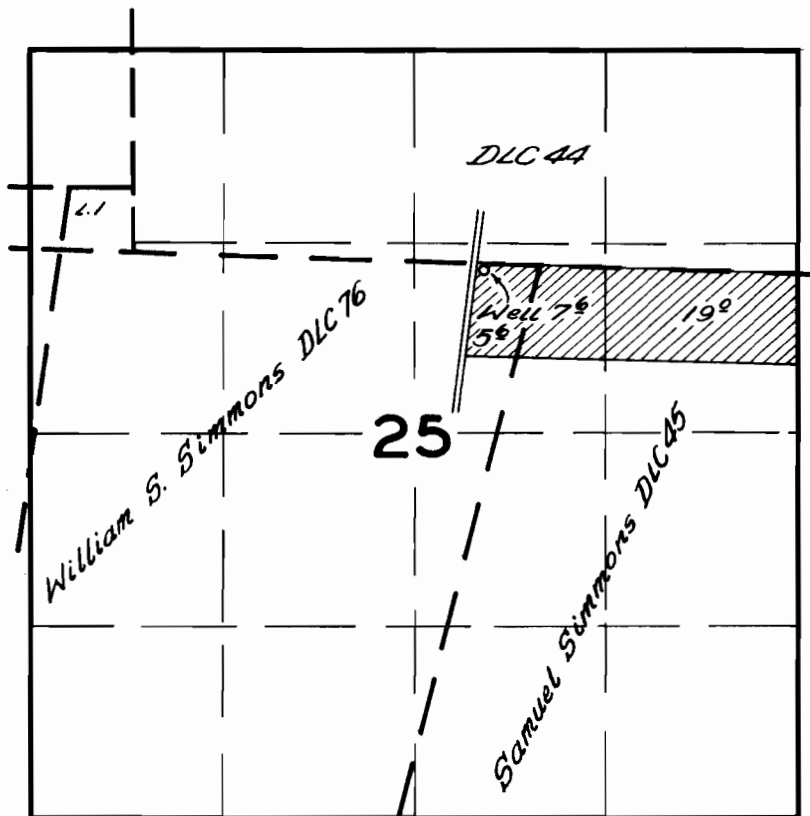

## FINAL PROOF SURVEY UNDER

Application No. *G-175* Permit No. *G-60*  
IN NAME OF

*ALLEN D. WIESMER*

Surveyed *Mar. 15, 1957*, by *C.O. Beattie*