


U-618  
C-23940

T. 6N. R. 34E. W.M.

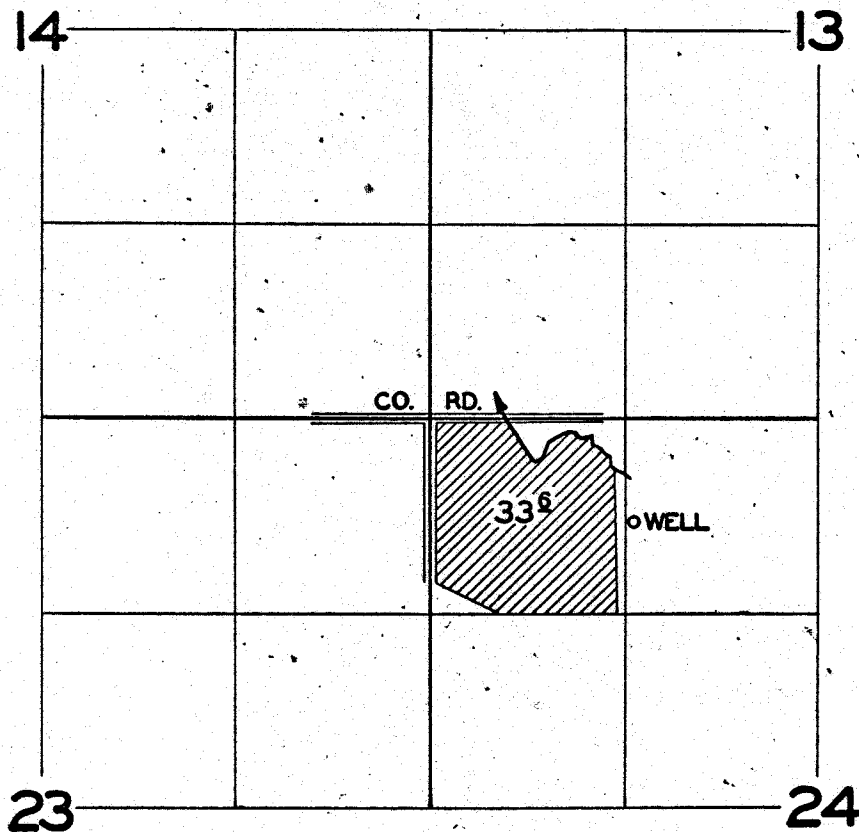

FINAL PROOF SURVEY  
UNDER

Application No. U-677 Permit No. U-618  
IN NAME OF

JOHN L. RICHARTZ

Surveyed JUNE 4, 1957, by C.O. Bartz