


T. 19S. R. 11W. W.M.

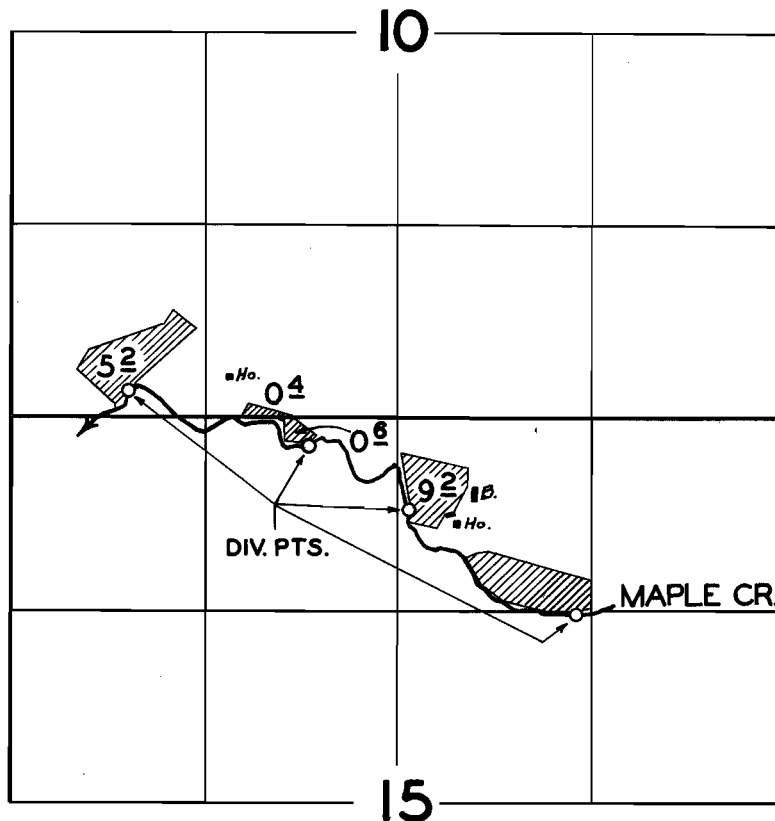

FINAL PROOF SURVEY
UNDER

Application No. 18861... Permit No. 14494...
IN NAME OF

JEMMA PRINDEL

Surveyed JUNE 14, 1957, by *[Signature]*