


T. 4 S. R. 3 W. W. M.

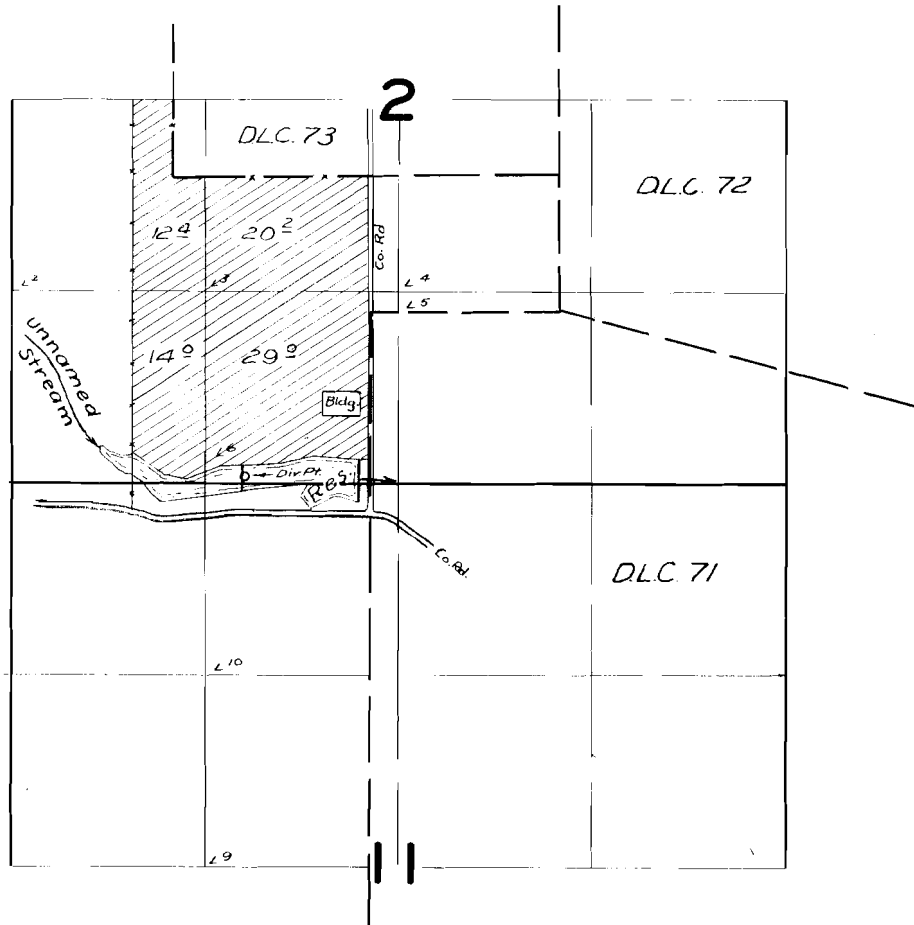

FINAL PROOF SURVEY

UNDER

R-22697

R-909

Application No. 22698 Permit No. 18026

IN NAME OF

Phillip A. Hawman

Surveyed *May 13* 1957, by *Tr. Bish*