


T.22S.R.3W.W.M.

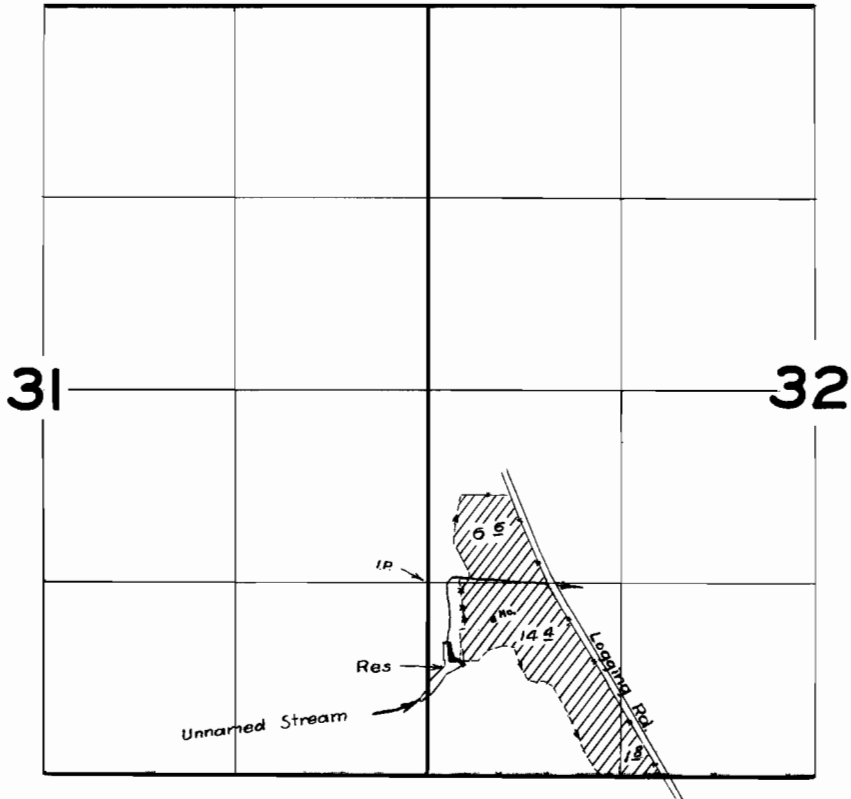

**FINAL PROOF SURVEY**

UNDER

R-25055

R-1093

Application No. ~~25056~~ Permit No. 19946

IN NAME OF

..... Lee E. Bechtold .....

Surveyed April 23, 1957, by *M. Bish* .....