


T. 3S. R. 1W. W.M.

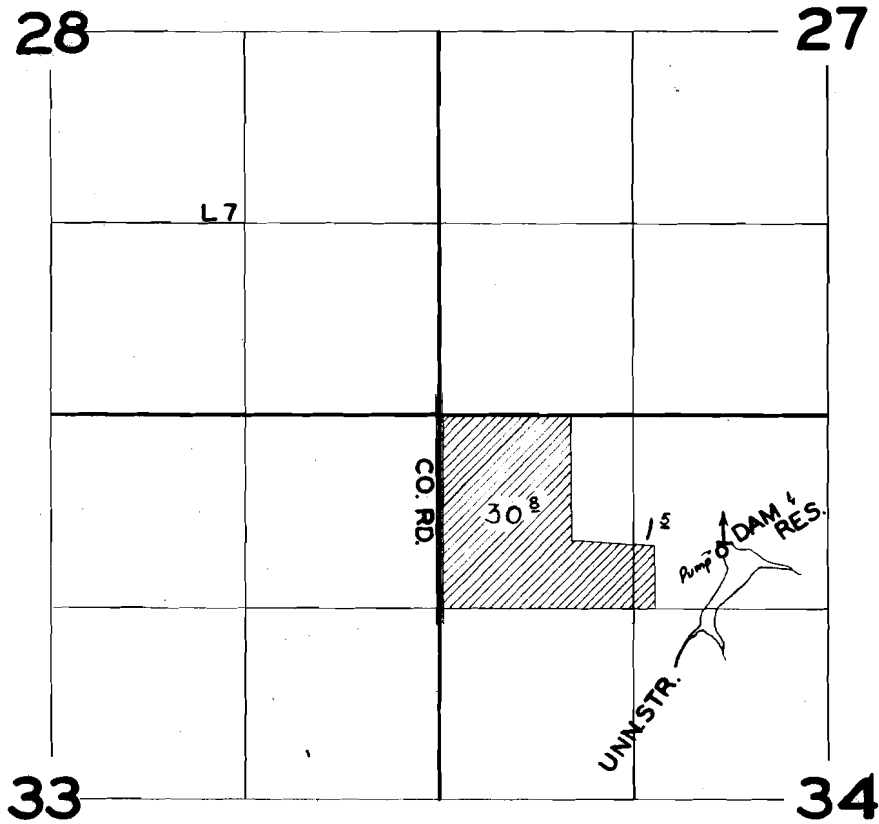

FINAL PROOF SURVEY

UNDER

R-25299

R-1134

Application No. 25300

Permit No. 20210

IN NAME OF

HAROLD D. MURRAY

Surveyed MAR. 26 1957, by C. O. BARTELS