


T. 3 S. R. 3 W. W. M.

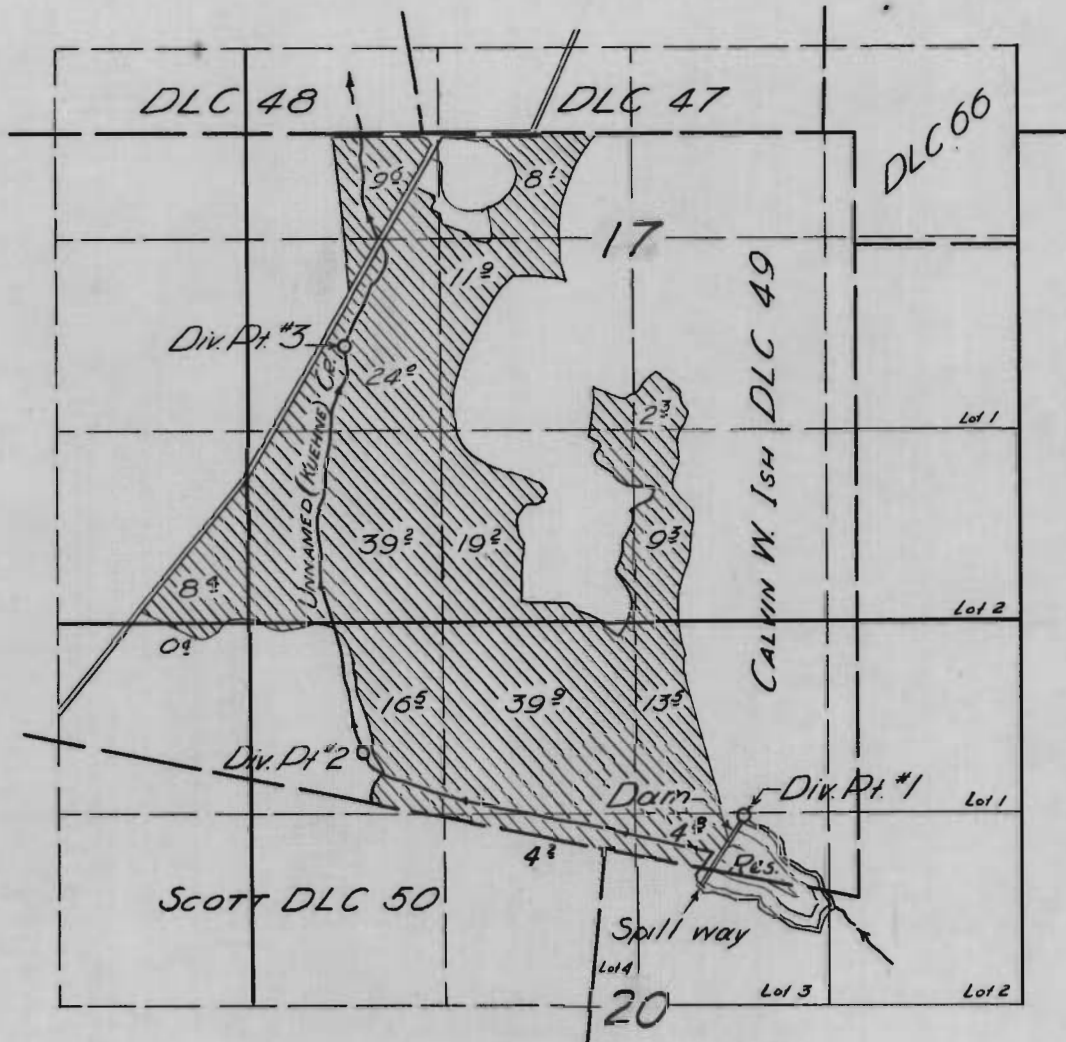

FINAL PROOF SURVEY

UNDER

R. 25783


R. 1157

Application No. 25784 Permit No. 20726

IN NAME OF

H. R. KUEHNE

Surveyed 5 Apr. 1956, by *[Signature]*

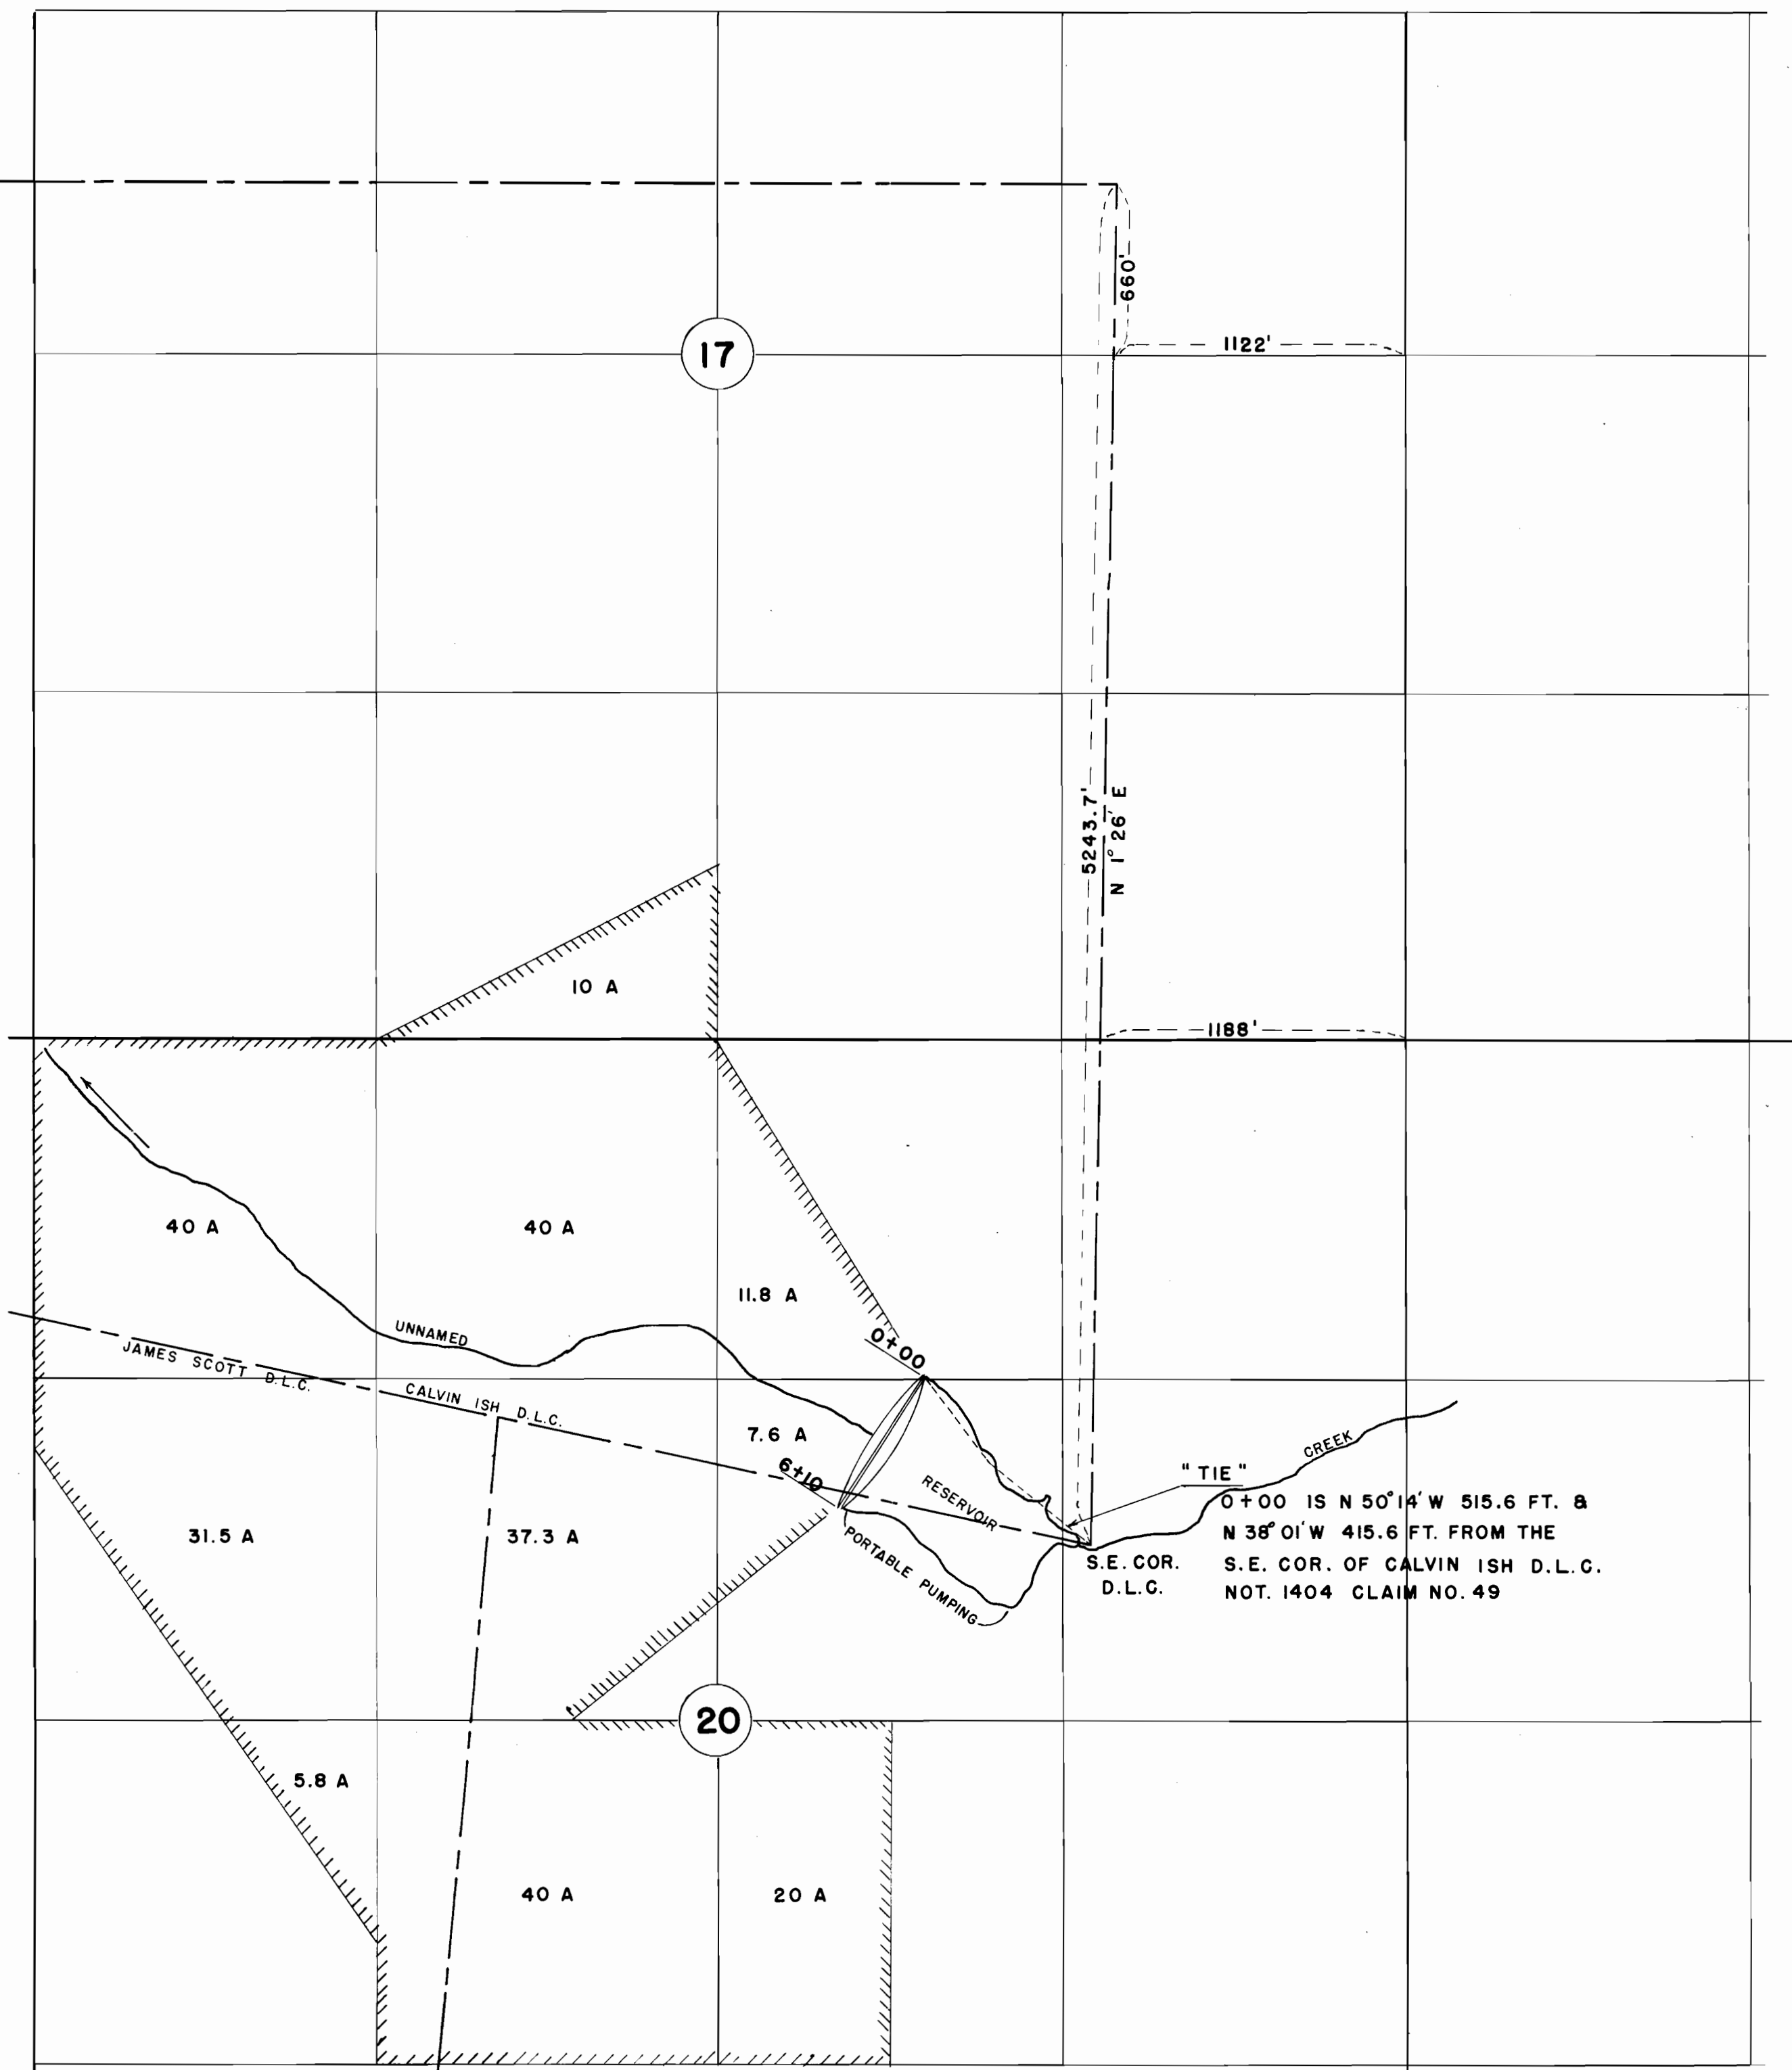

SCALE: 1" = 500'

////// = BOUNDARIES OF LAND TO BE IRRIGATED

ENTIRE AREA SHOWN ON MAP OWNED BY H. R. KUEHNE

Application No. R-25783
25784
Permit No. R-1100
1271



H. R. KUEHNE
IRRIGATION PROJECT

SECTIONS 17 & 20, TP 3 S, R 3 W, W.M.
YAMHILL COUNTY, OREGON

MARCH 20, 1951

BY O. C. YOCOM CO.