


T. 8S. R. 2W. W.M.

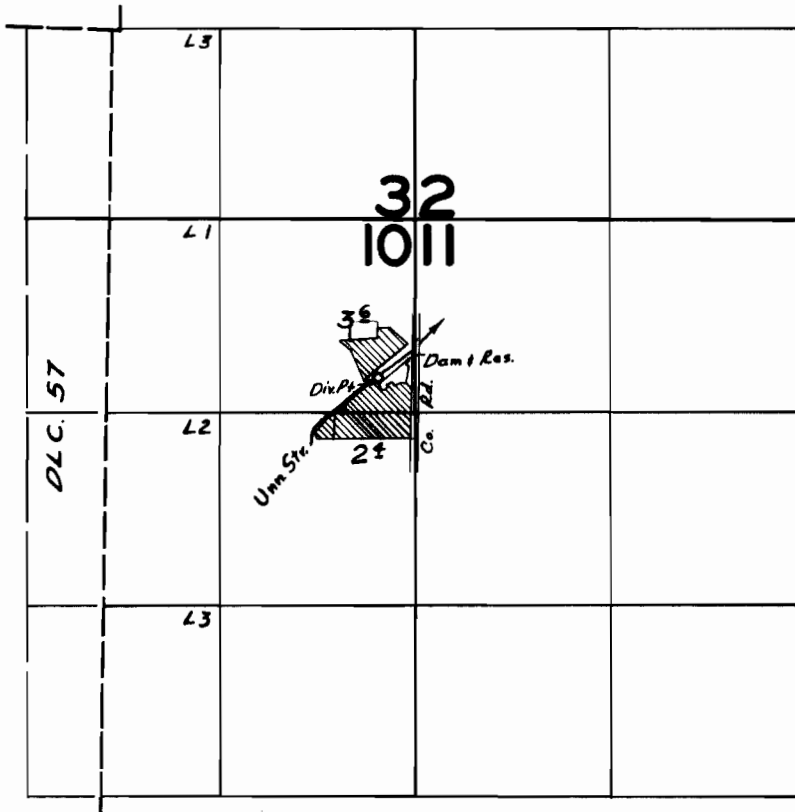

FINAL PROOF SURVEY

UNDER

R28168

R-1486

Application No. 28169 Permit No. 22167

IN NAME OF

DARYL E. OTJEN

Surveyed MAR. 27, 1957, by C.O. BARTELS