


APPLICATION MAP APPROPRIATION OF PUBLIC WATERS IN STATE OF OREGON

The Booth-Kelly Lumber Company
Sections 4 & 9-T 22 S-R 2 W-W.M.
Scale=1"=1,000' March 16, 1953.

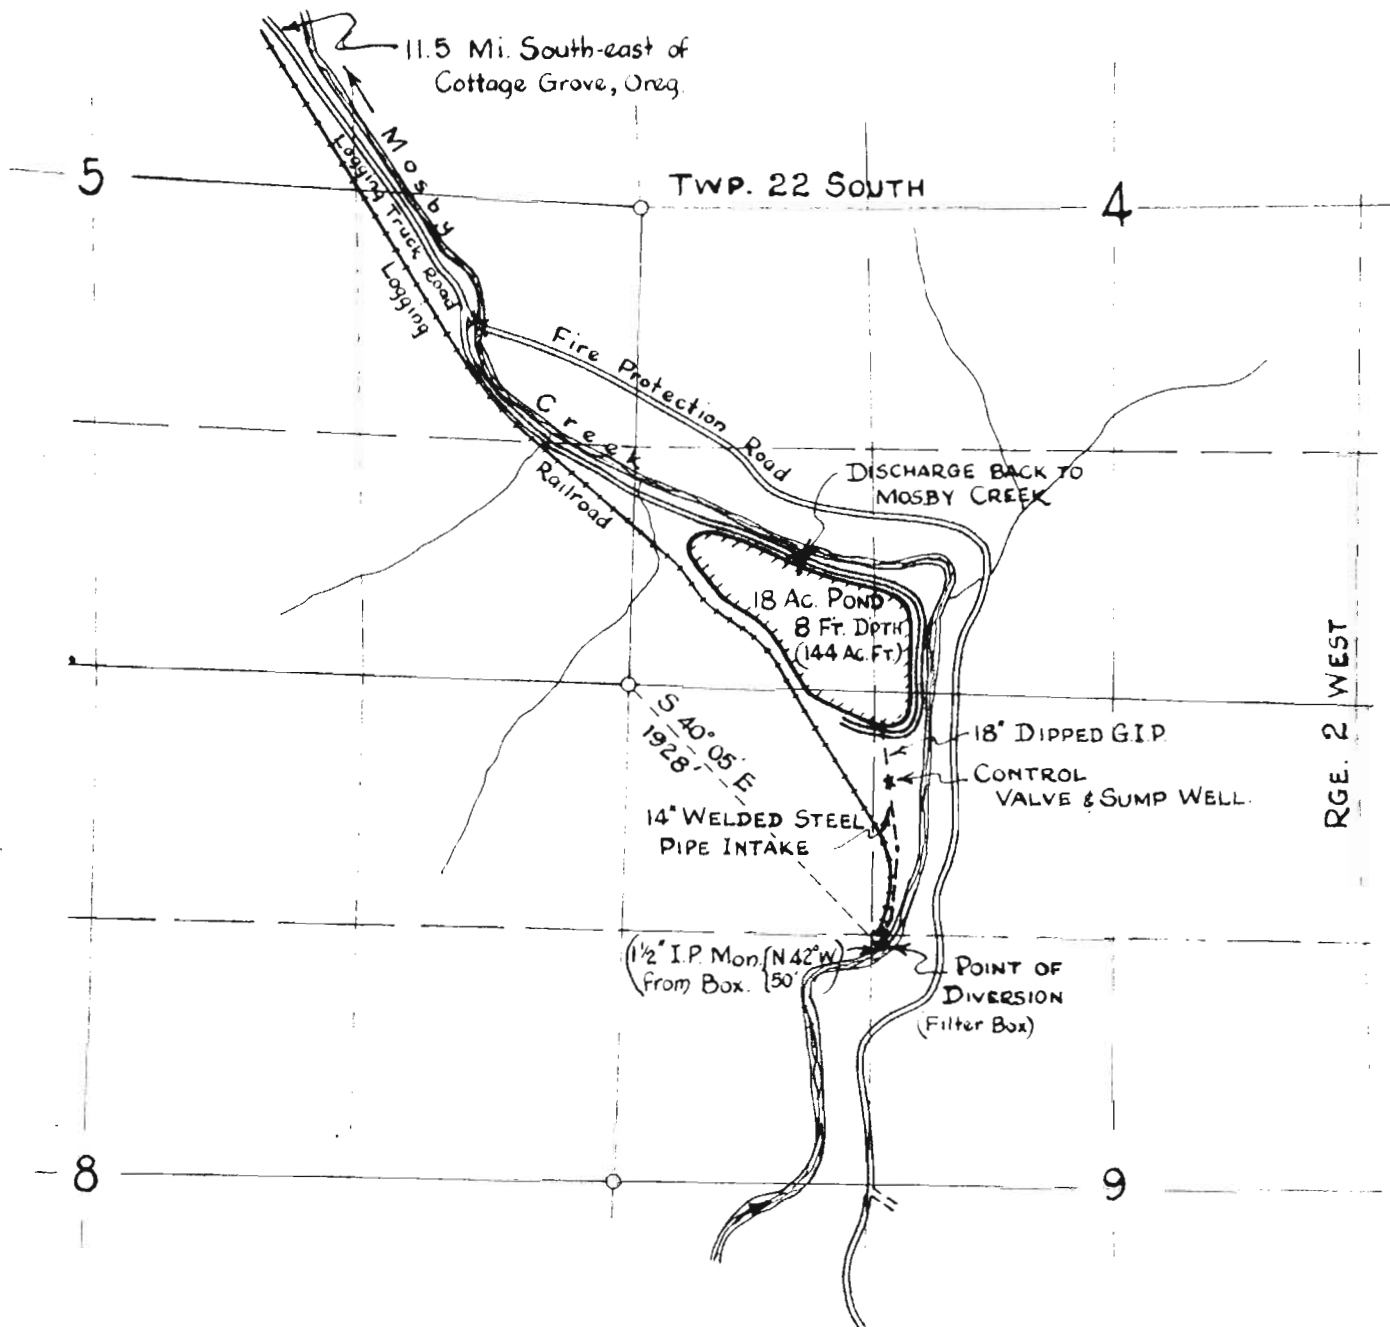

I, Carl W. Raynor, of The Booth-Kelly Lumber Company do hereby certify that this map was made from notes taken during an actual survey made under my immediate supervision on November 14, 1952; that the monument shown on this map consists of 1 1/2" I.P. 18" above solid rock surface is S 40° 05' E - 1928 Feet From NW Corner Section 9.



Application No. R-28244
Permit No. 28245