


APPLICATION MAP APPROPRIATION OF PUBLIC WATERS IN STATE OF OREGON

The Booth-Kelly Lumber Company

Sections 4 & 9 - T 22 S - R 2 W - W.M.

Scale = 1" = 1,000'

March 16, 1953.

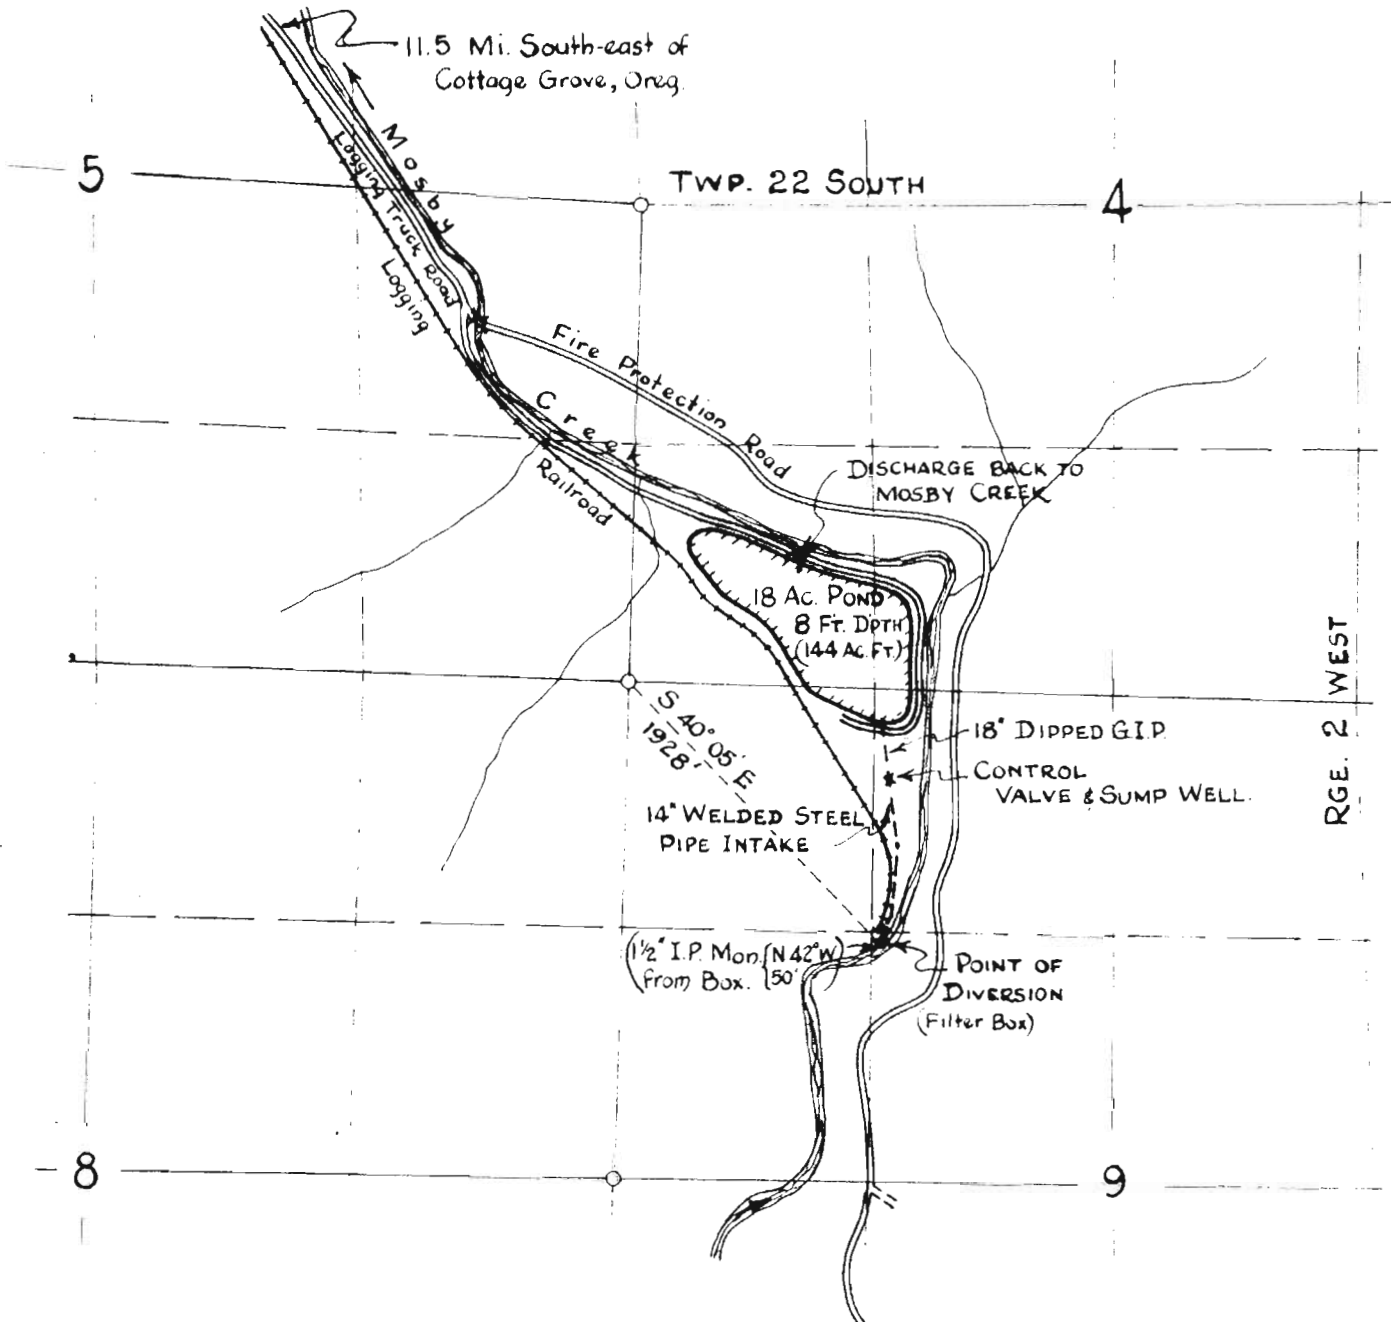

I, Carl W. Raynor, of The Booth-Kelly Lumber Company do hereby certify that this map was made from notes taken during an actual survey made under my immediate supervision on November 14, 1952; that the monument shown on this map consists of 1 1/2" I.P. 18" above solid rock surface is S 40° 05' E - 1928 Feet From NW Corner Section 9.



Application No. R-28244
Permit No. 28245