

100' 100' 100'
 100' 100' 100'
 100' 100' 100'

60' COMM'L. AVE. W.

HIGHLAND AVE. W. 8'

100'	6	45'
40	5	40
40	4	40
19	3	40
40	11	2
45	12	1
100'	100'	45'

60' PARK AVE. W.

45'	100'	45'
40	8	40'
40	9	40'
40	10	40'
40	11	40'
100'	100'	40'

60' ALDER AVE. W.

50'	100'	100'	50'
40	7	6	40
40	8	5	40
40	9	4	40
40	10	3	40
40	11	2	40
50'	12	1	50'
100'	100'	100'	50'

50'	100'	100'	50'
40	7	6	40
40	8	5	40
40	9	4	40
40	10	3	40
40	11	2	40
50'	12	1	50'
100'	100'	100'	50'

60' BIRCH AVE. W.


40'	100'	40'
40'	9	40'
40'	10	40'
40'	11	100'

Mingus Park Creek



I, C.G. Reiter of Coos Bay, Ore.
 do hereby certify that this map was made from
 notes taken during an actual survey made
 under my immediate supervision on July 9, 51,
 that the 2" I.P. is located as described and shown.

C.G. Reiter Reg. #25

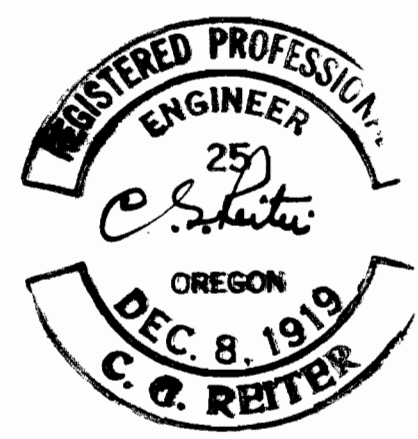

ELEVENTH ST. N.

Mingus Park Lake

Note! Dam was formed by filling entire low land area

Rock Headwall

Conc. Outlet Box

Placed 2" I.P. - Reference Tie
 NORTH 1, 175.8' ± EAST 695.2' to
 1/4 COR. 8 BTW. SEC'S 26, 27
 TWP. 25S., R. 13W.W.M.

45'	100'	100'	45'
50'	13	2	50'
50'	14	1	50'
100'	100'	100'	50'

60' CEDAR AVE

Boundary - Mingus Park

TENTH ST. N.

4" 4" Conc. Box Sewer to City Sewer

8th TERRACE

PARK AVE.

Application No. R-29475
 Permit No. 26249
 R-1718

23423

CITY OF COOS BAY, OREGON
ENGINEERING DEPARTMENT

WATER RIGHTS LOCATION MAP
 MINGUS PARK LAKE - SEC. 27 - TWP. 25S. - R. 13W.W.M.
 Date - 7-11-51 SCALE 1"=100' Drwg. E.A.M.

26249