


T. 35 S., R. 2 W., W.M.

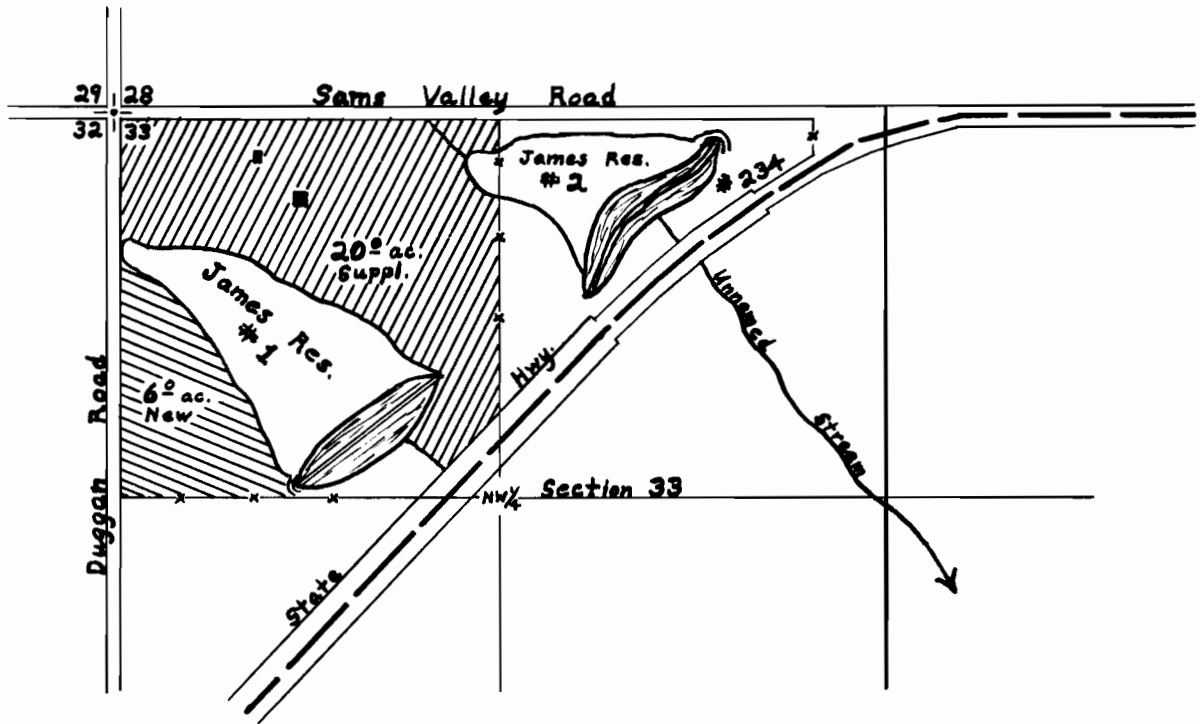

Scale: 8 inches = 1 mile

### FINAL PROOF SURVEY

UNDER

R-30574

R-1855

Application No. 30575 Permit No. 24165

IN NAME OF

Lester E. James

Surveyed March 14, 1958, by D.C. Hendrix, W.M.