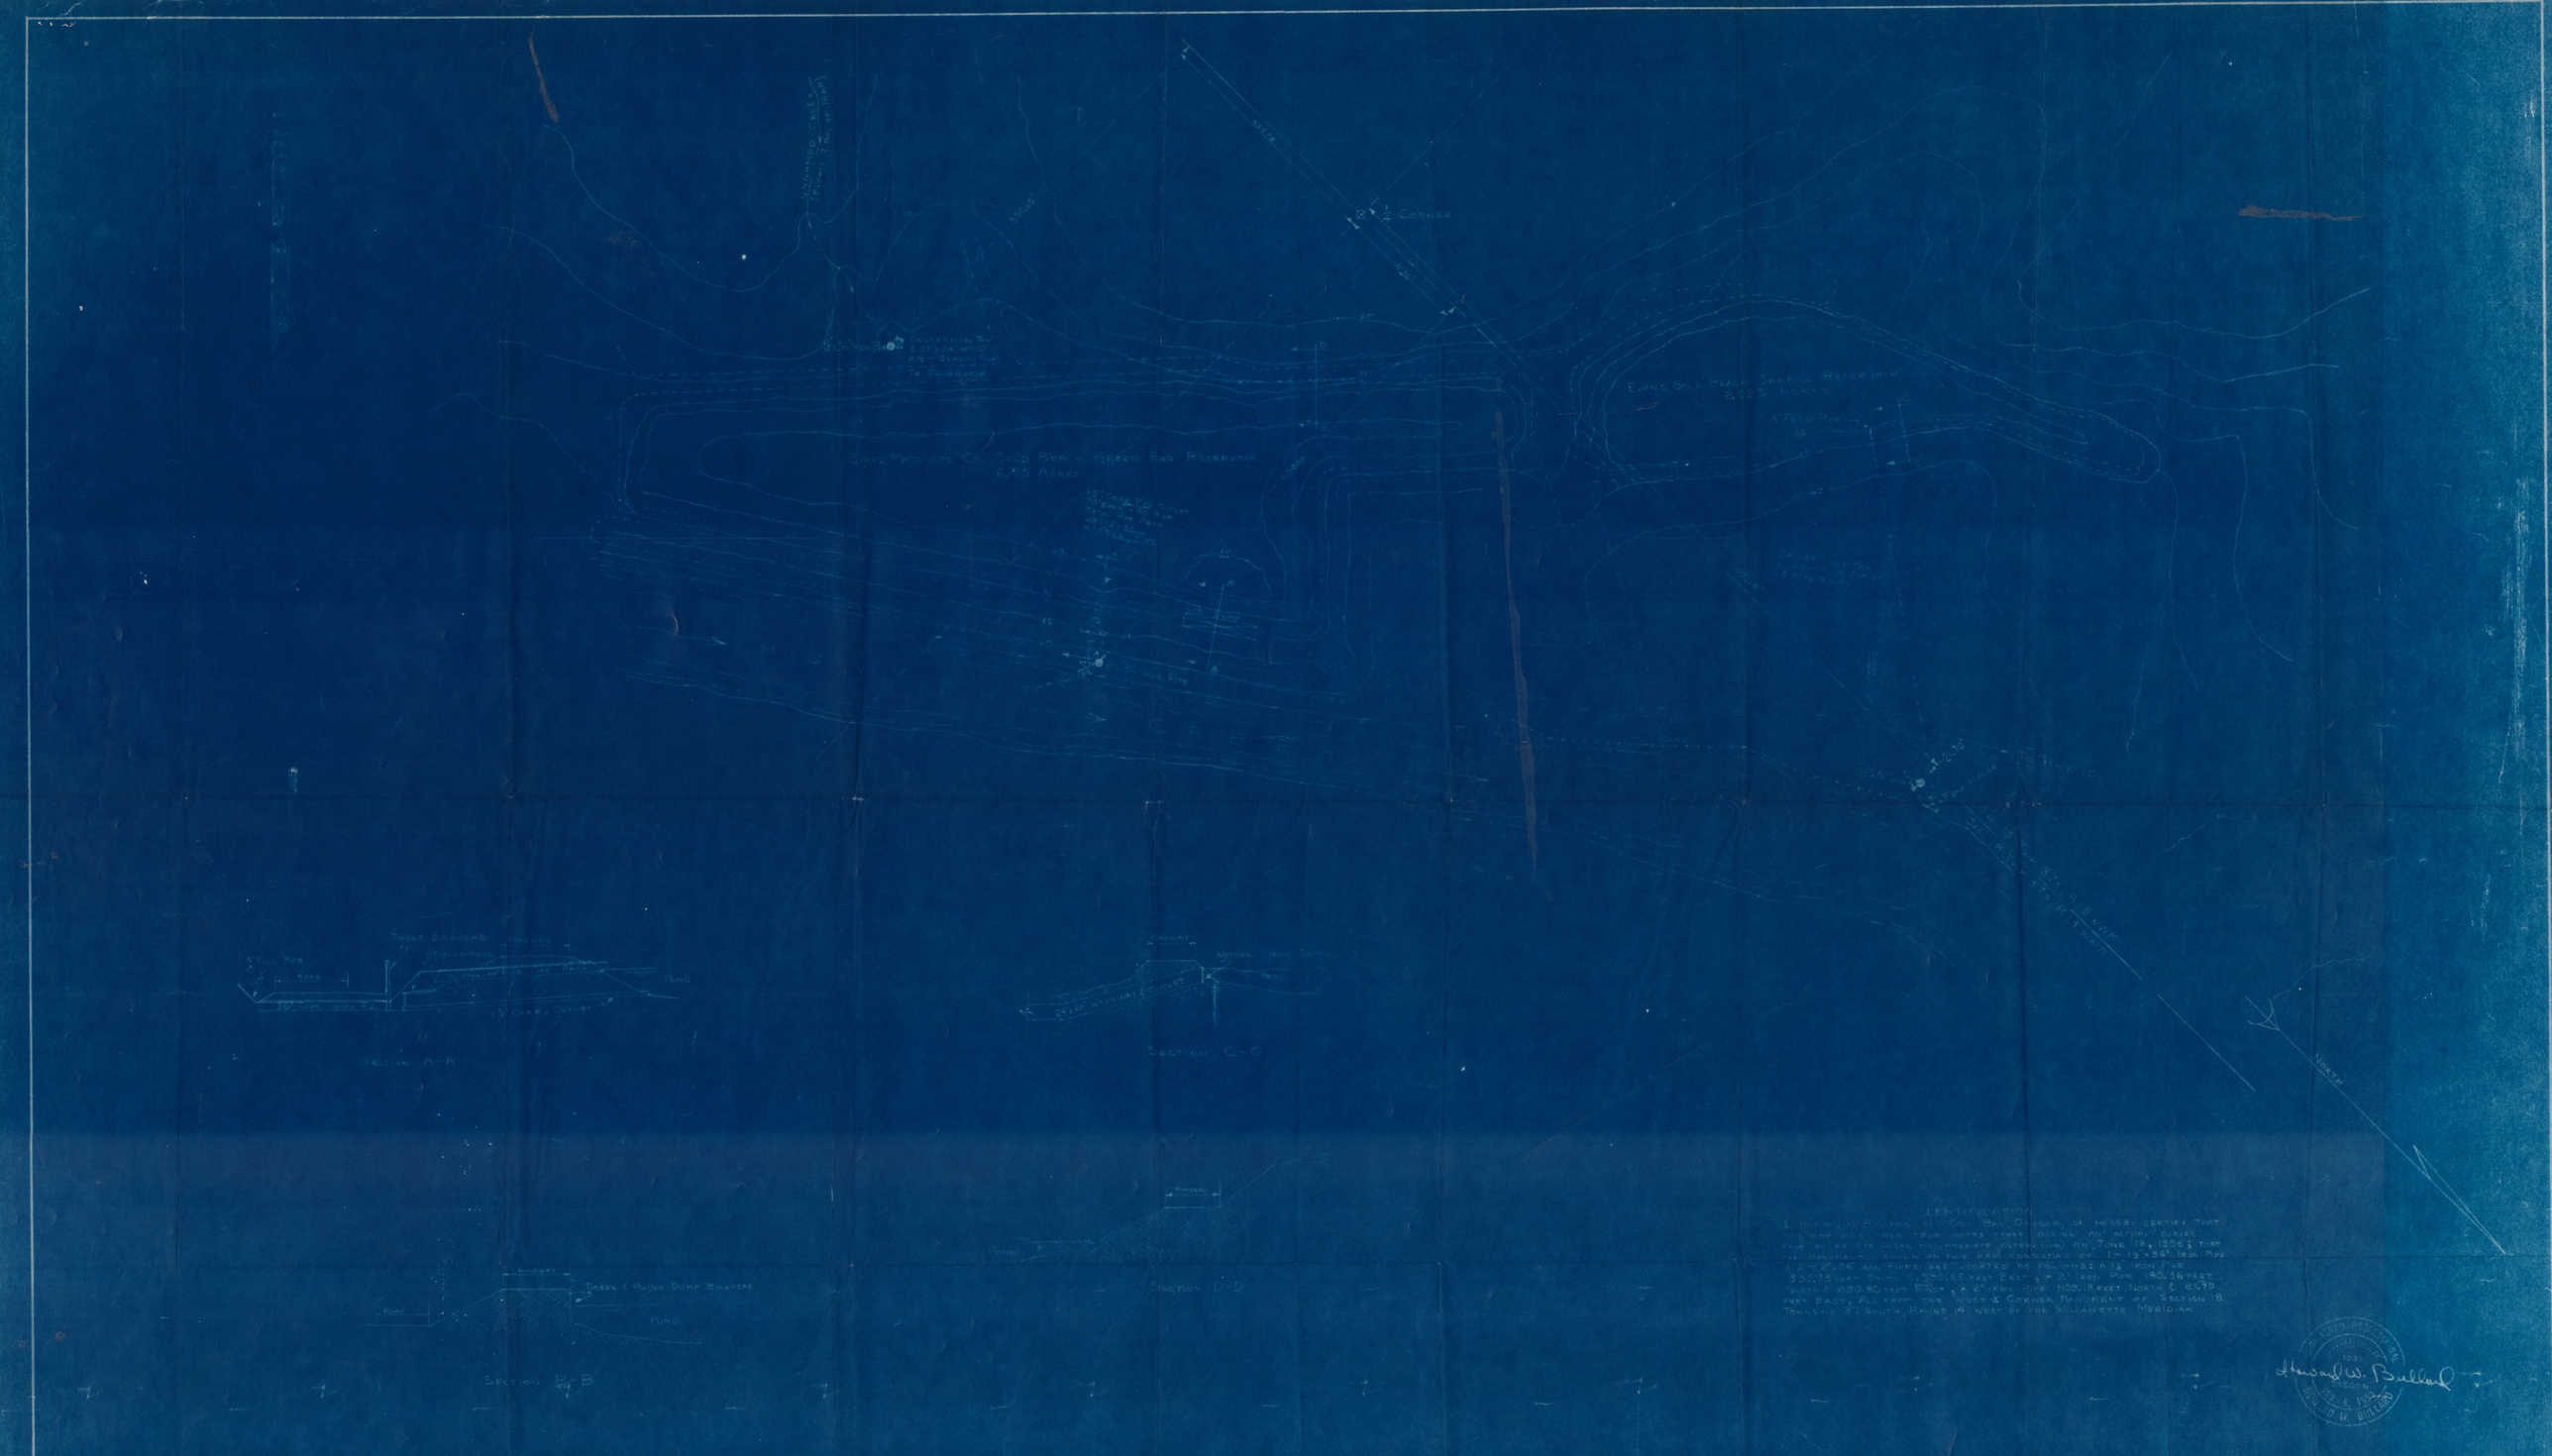


CERTIFICATION

I, HAROLD W. BULLARD OF COOS BAY, OREGON, DO HEREBY CERTIFY THAT THE MAP HEREON WAS PREPARED UNDER MY DIRECTION FROM AN ACTUAL SURVEY MADE BY ME OR UNDER MY DIRECTION ON JUNE 19 & 1956 & THAT THE DIVERSION SHOWN ON THIS MAP CONSISTING OF 1 - 12 x 36" IRON PIPE & 2 - 24" IRON PIPES ARE LOCATED AS FOLLOWS: A 1/2" IRON PIPE 335.75 FEET SOUTH & 1320.65 FEET EAST & A 2" IRON PIPE 180.36 FEET SOUTH & 680.80 FEET EAST & A 2" IRON PIPE 108.1 FEET NORTH & 67.30 FEET EAST & ALL BEING THE WEST 1/4 CORNER MONUMENT OF SECTION 18 TOWNSHIP 34 SOUTH RANGE 14 WEST OF THE WILLAMETTE MERIDIAN.

Harold W. Bullard

REGISTERED LAND SURVEYOR
OREGON
JULY 23, 1957
HAROLD W. BULLARD

TOLERANCES UNLESS OTHERWISE SPECIFIED		REVISIONS		
		NO.	DATE	DESCRIPTION
DECIMAL DIM. ± OR — .005				
FRACTIONAL DIM. ± OR — 1-64"				
MACHINE FINISH SYMBOLS				
1	ROUGH CUT			
11	FINISH CUT			
8	GRIND			
16	FINE GRIND			
√	POLISH OR LAP			

DET.	NO. REQ'D.	SIZE OR PATTERN NO.	MAT'RL	REM'KS

EVANS PRODUCTS CO.
COOS BAY, OREGON

DATE	7-26-56
SCALE	1" = 100'
DRAWN BY	F. ANDERSON
CHECKED BY	
APPROVED	

TOOL OR MACHINE: Evans Prod. Co. Gold Beach (Hunter Creek) Ponds
DESCRIPTION: Location of Diversion Pipe Monumented
REMARKS:

SHEETS A	SHEETS B	NO.
SHEETS C	SHEETS D	528

C-35-20 Sheet 1 of 2