


# T. 3N. R. 9&10W. W.M.

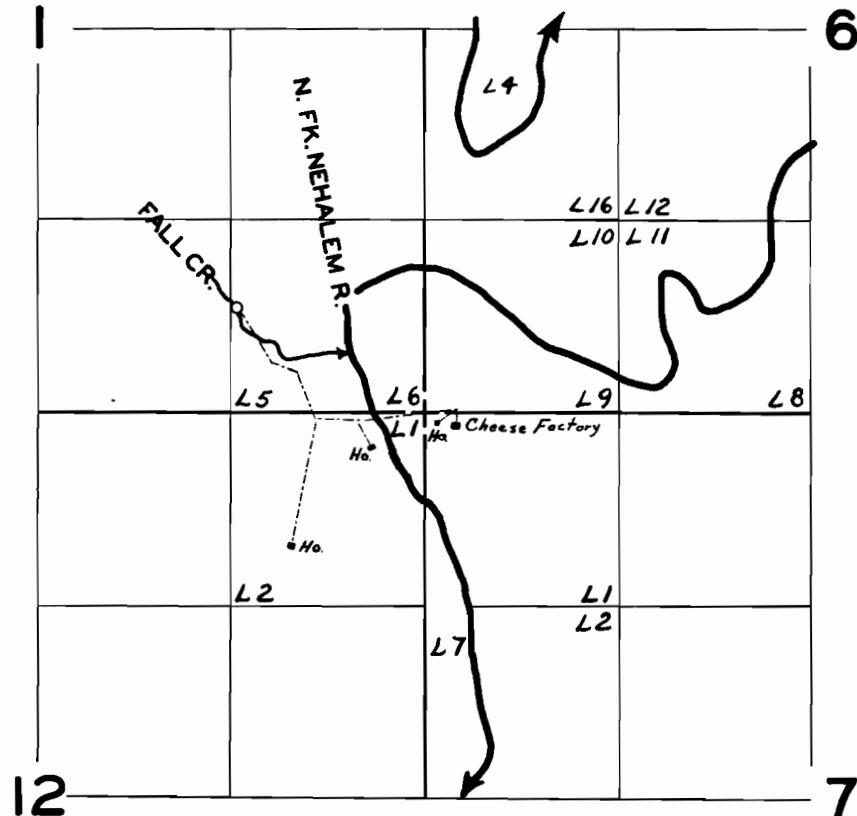

LAND SURVEYED & OWNED  
UNDER

Application No. 19150 Permit No. 14745  
IN NAME OF

W.K. SCOVELL

Surveyed AUG. 27 1957, by C.O. BARTELS