


T. 4S. R. 2W. W.M.

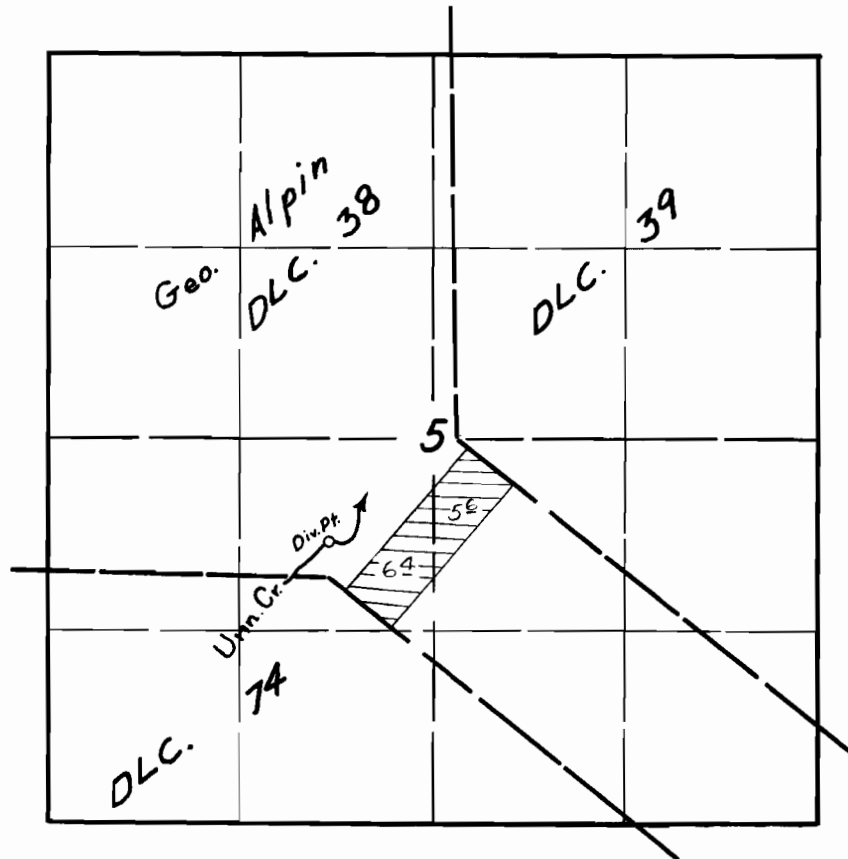

FINAL PROOF SURVEY

UNDER

Application No. 19527 Permit No. 15117

IN NAME OF

Anna C. Sprogis

Surveyed 27 Sept. 1956, by M. Bish

DFN-3D-171

620