


T.18 S.R.26 E.W.W.

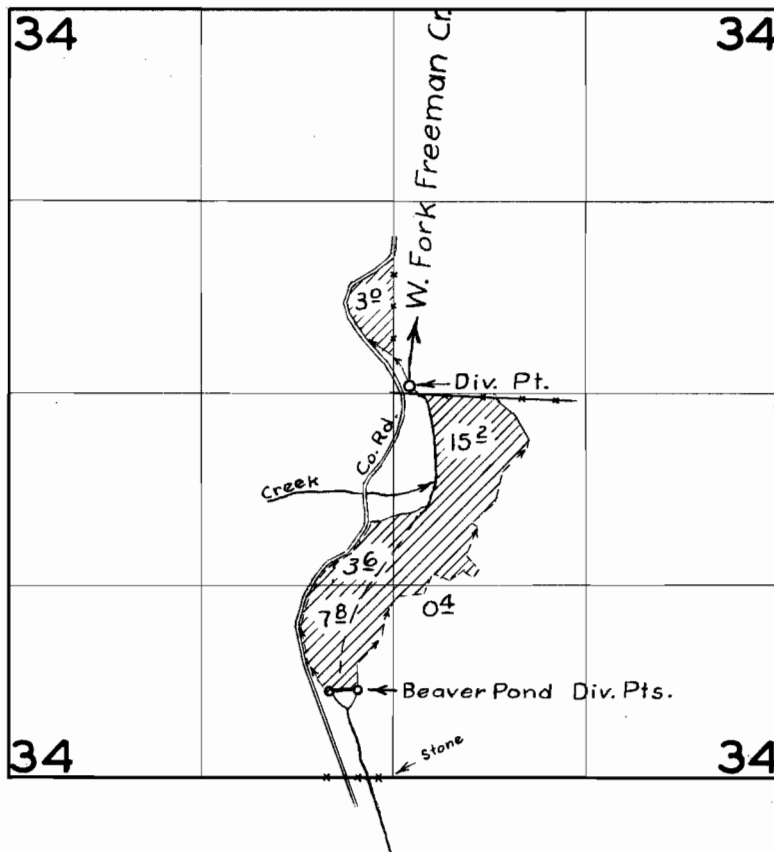

FINAL PROOF SURVEY
UNDER

Application No. 20004 Permit No. 15564
IN NAME OF

J. H. Harris, Inc.

Surveyed Sept. 19 1957, by M. Besh