


T. 5S. R. 10W. W.M.

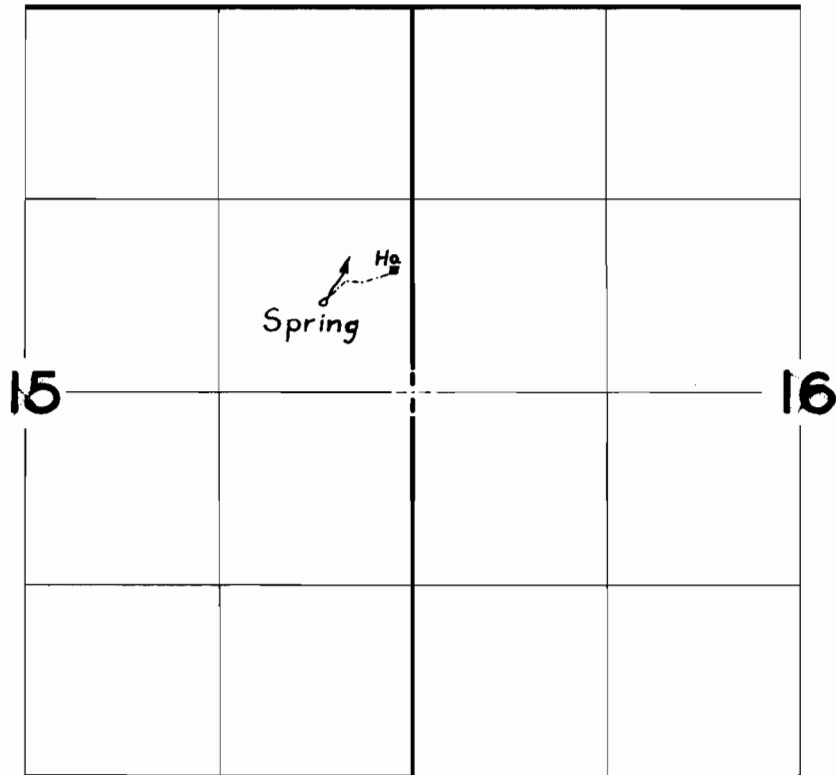

FINAL PROOF SURVEY
UNDER

Application No. 20137 Permit No. 15698
IN NAME OF

Albert Edward & Theresa May Layer

Surveyed AUG. 29 1957, by *[Signature]*