


T.14S.R.5W.W.M.

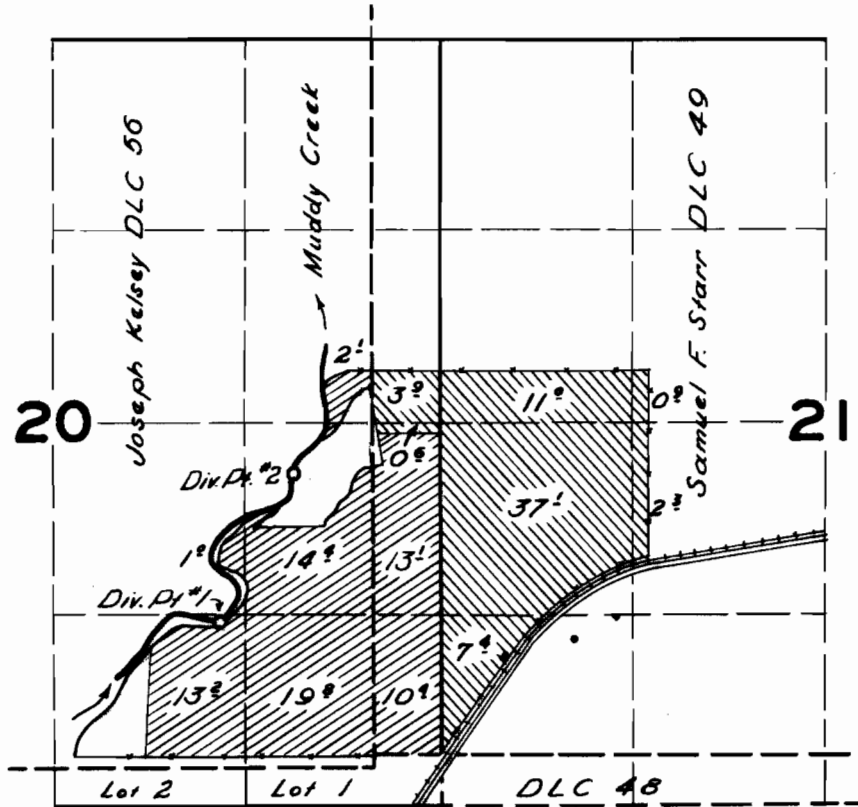

FINAL PROOF SURVEY

UNDER

Application No. 20489 Permit No. 15996
25351 Permit No. 19880



IN NAME OF

H. C. OSBORNE

Surveyed 25 Apr. 1957, by [Signature]