


T. 10S. R. 6W. W.M.

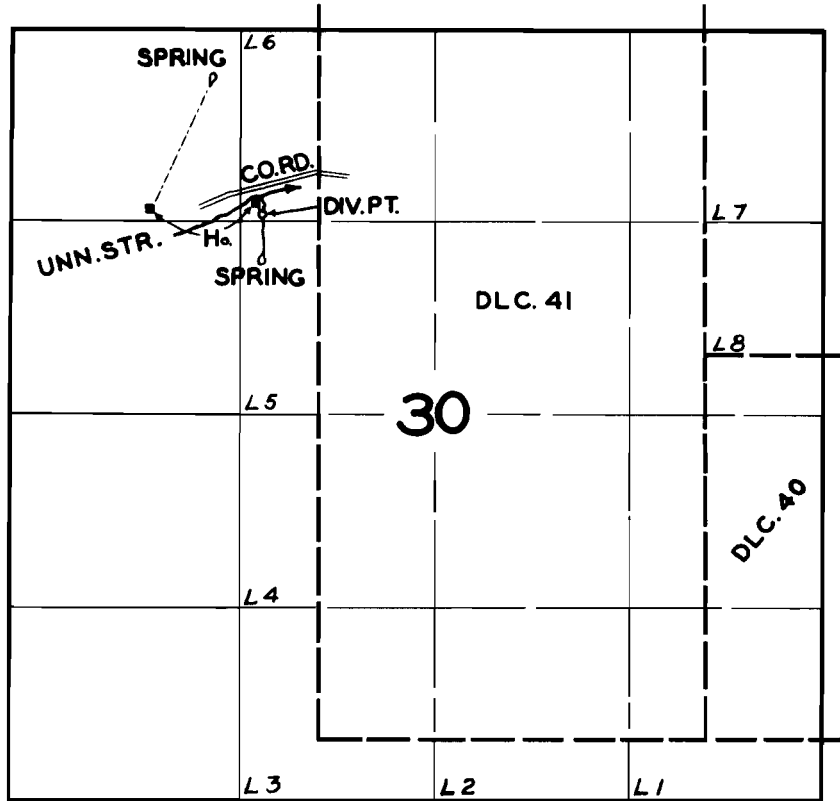

FINAL PROOF SURVEY
UNDER

Application No. 20696. Permit No. 16189
IN NAME OF

..... REX & ETHEL CLEMENS

Surveyed SEPT. 3. 1957, by *[Signature]*