


T. 2S. R. 3W. W.M

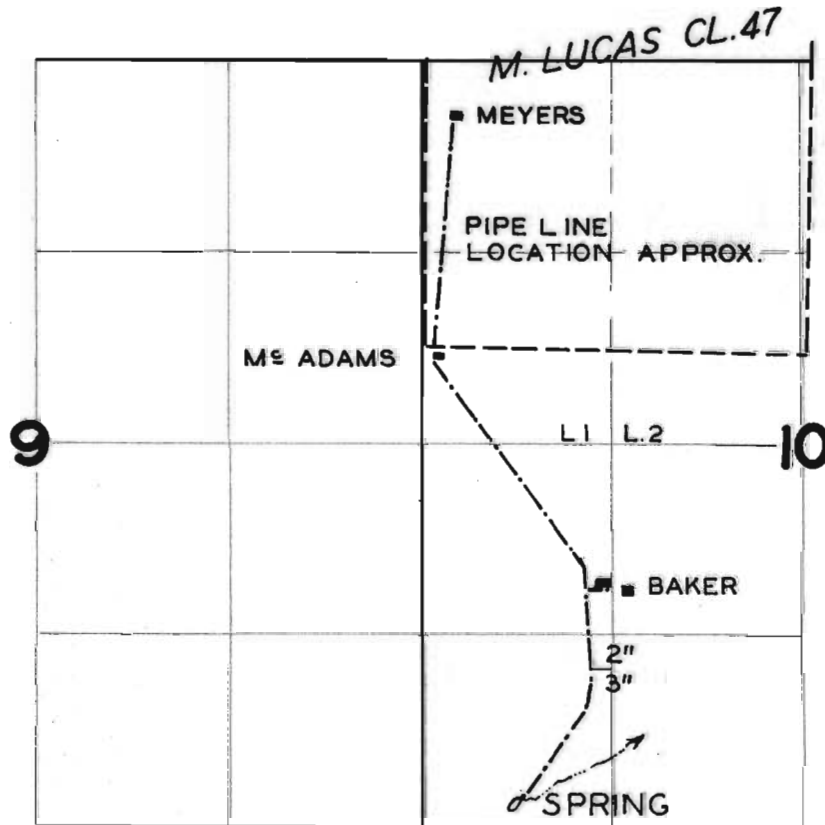

FINAL PROOF SURVEY UNDER

Application No. 21438. Permit No. 16819.
IN NAME OF

E. M. BAKER, K. M. ADAMS & MEYERS ESTATE

Surveyed JUNE 8, 1951, by H. L. COFFMAN