


T. 6S. R. 11W. W.M.

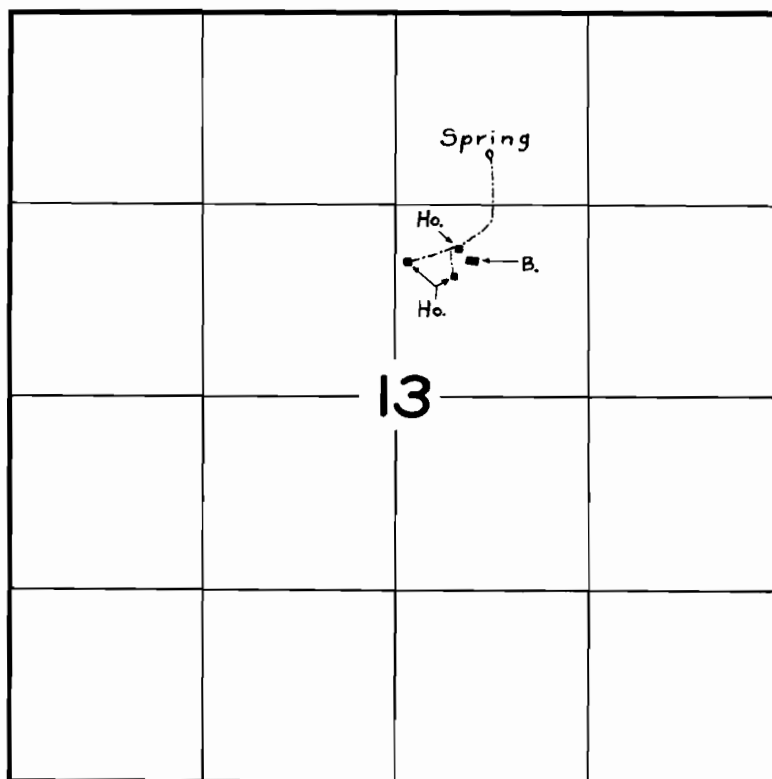

FINAL PROOF SURVEY
UNDER

Application No. 21498 Permit No. 16861
IN NAME OF

Nettie M. Walls

Surveyed AUG. 28, 1957, by *[Signature]*