


T17S R1WWM

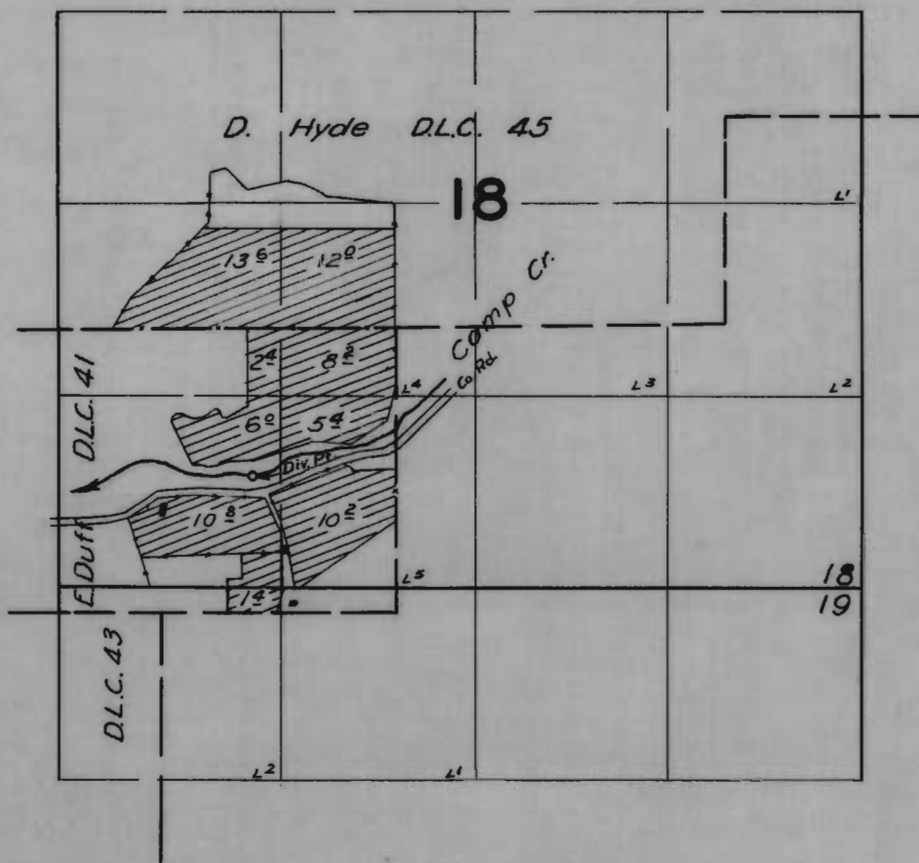

FINAL PROOF SURVEY UNDER

Application No. 21743 Permit No. 17110
IN NAME OF

Eugene Fisher

Surveyed May 10 1957, by Tr. Bish