


T.2S.R.6E.W.M.

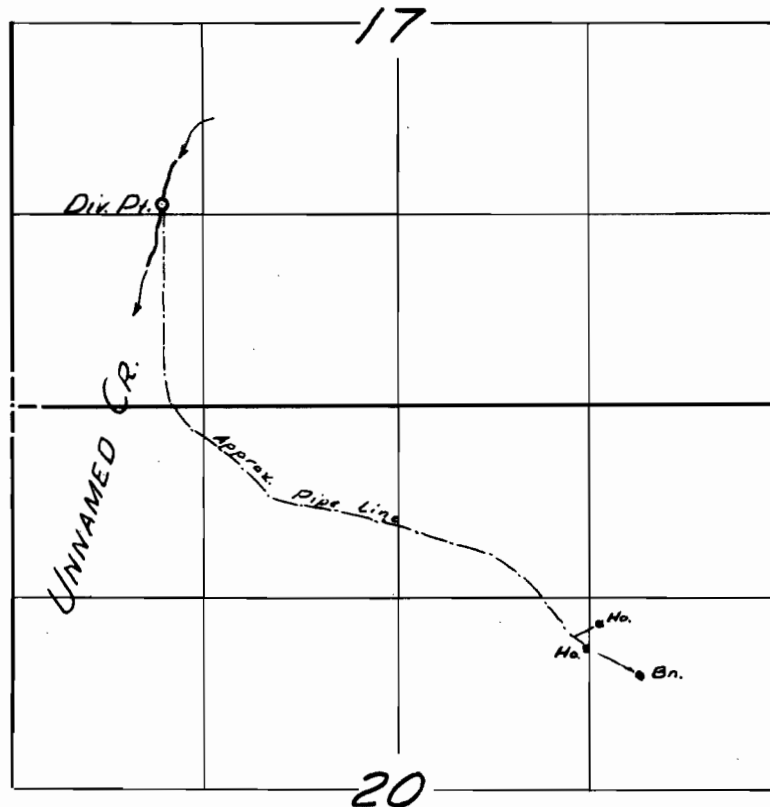

**FINAL PROOF SURVEY**  
UNDER

Application No. 21984 Permit No. 17289  
IN NAME OF

J. R. BARTHOLOMEW

Surveyed 24 June 1956, by [Signature]