


T. 30S. R. 3W. W.M.

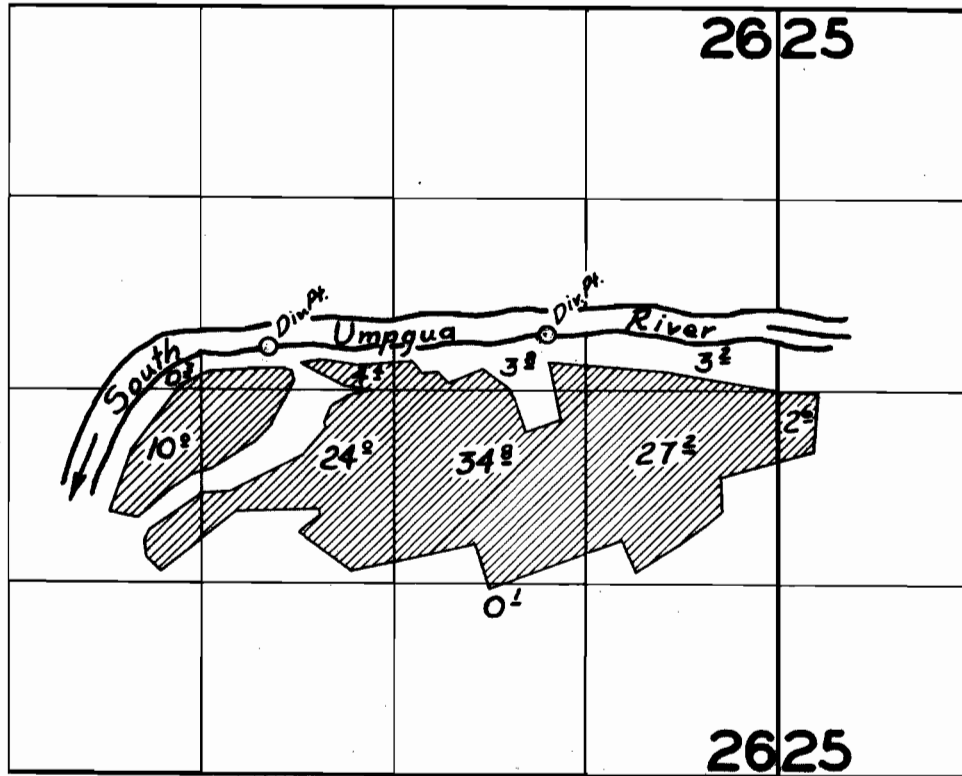

FINAL PROOF SURVEY

UNDER

Application No. 21953 Permit No. 17319

IN NAME OF

**WESTERN OREGON CONFERENCE
ASSOCIATION OF SEVENTH DAY ADVENTISTS**

Surveyed JUNE 23 1957, by C. O. Gault