


3
T.26S.R.4 W.W.M.

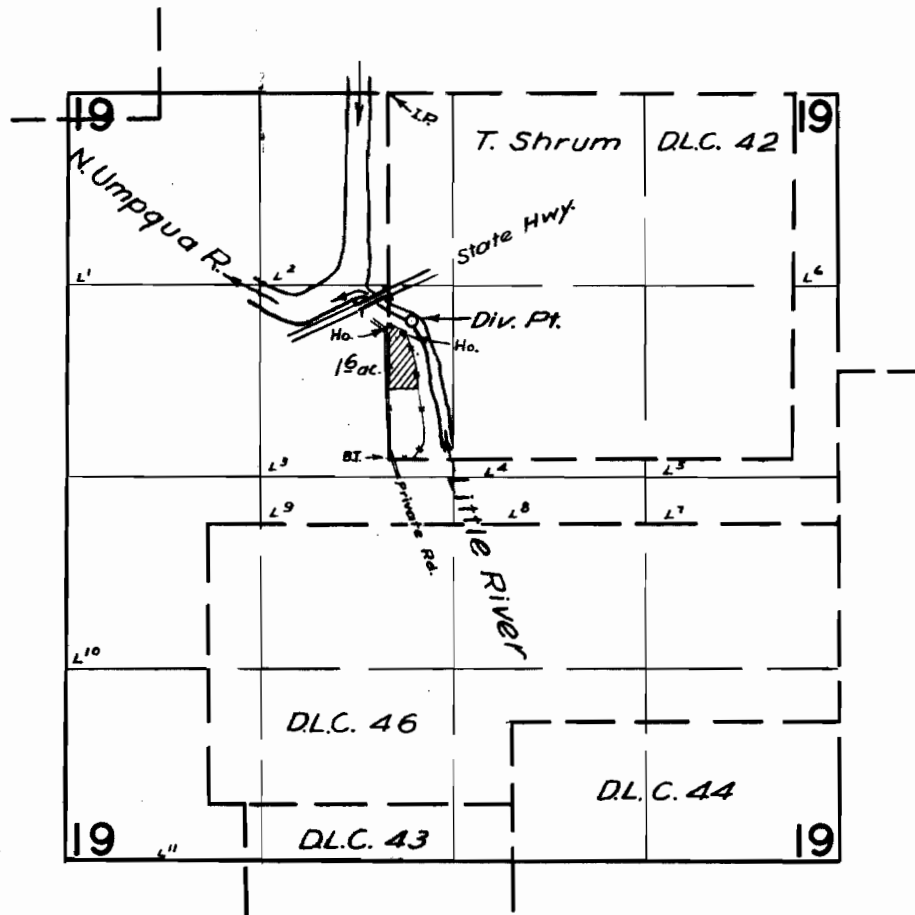

FINAL PROOF SURVEY
UNDER

Application No. 22069 Permit No. 17413
IN NAME OF

Helen Glenn

Surveyed Aug 13 1957, by M. Biel