


T.6S. R.8W.W.M.

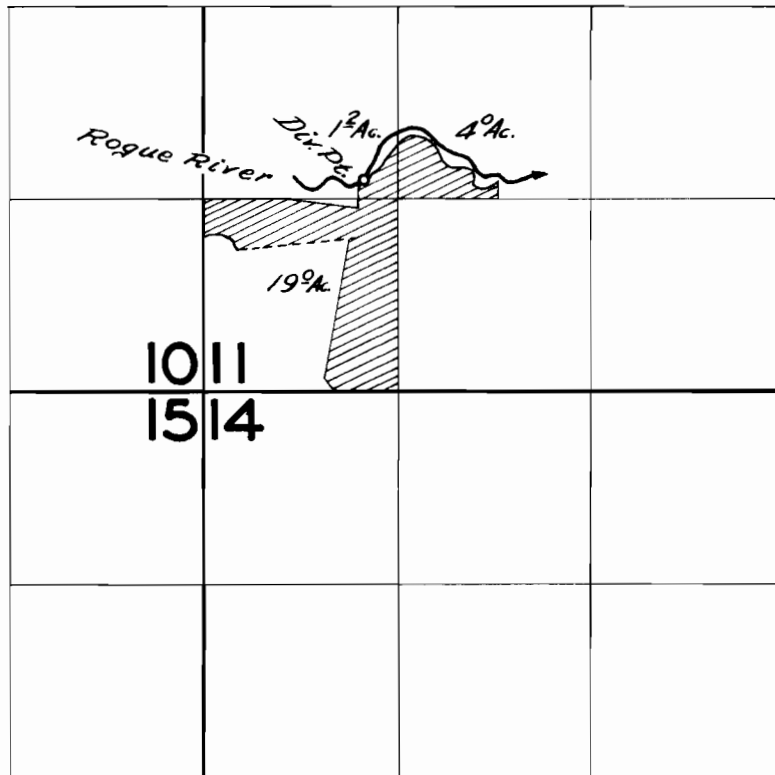

FINAL PROOF SURVEY
UNDER

Application No. 22831 Permit No. 17964
IN NAME OF

Orien F. Otjen

Surveyed *Sept. 20* 1957, by *C.D. Bastick*