


T.2S. R.1W. W.M.

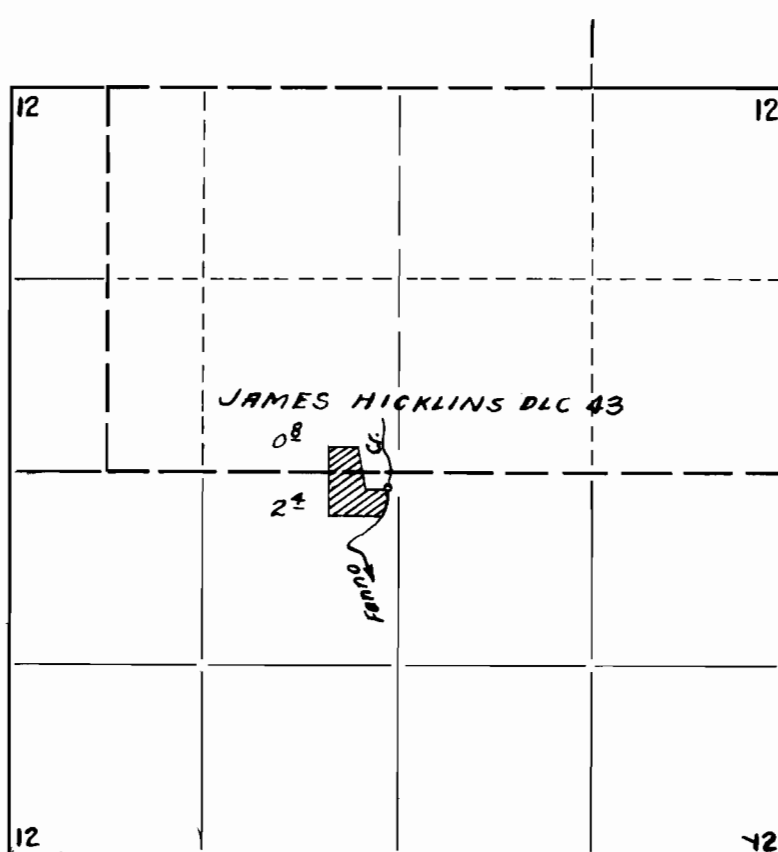

FINAL PROOF SURVEY

UNDER

Application No. 23163 Permit No. 18245

IN NAME OF

S. J. PETERSEN

Surveyed 5 - 9, 1956, by R.H. WHITBY