


T.25 S.R.2 W.W.M.

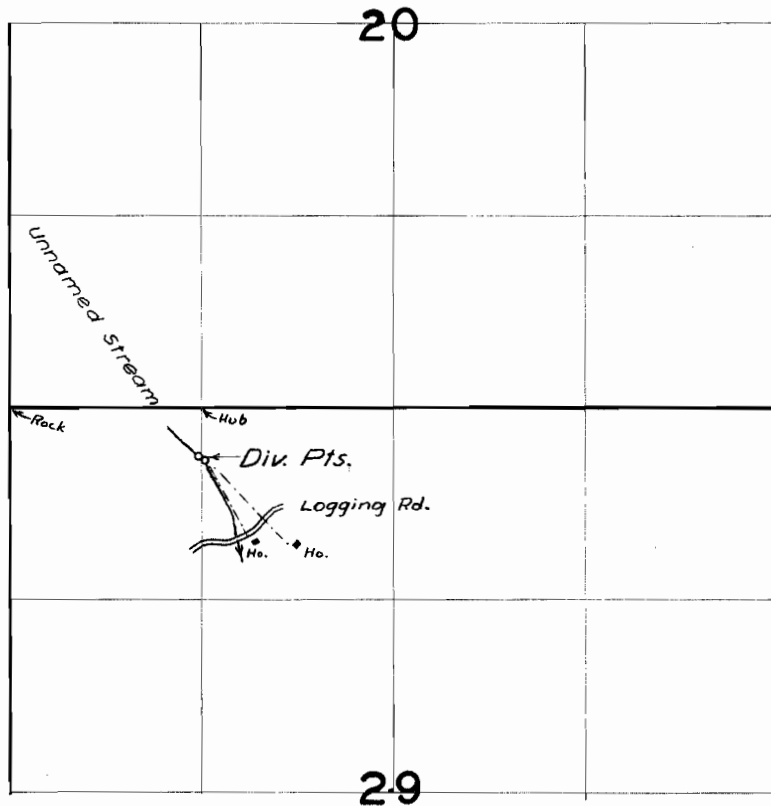

FINAL PROOF SURVEY
UNDER

Application No. 23169 Permit No. 18248
IN NAME OF

Kenneth F. Taylor

Surveyed Aug 13 1957, by m. Rich