


T.16 S.R.2 W.W.M.

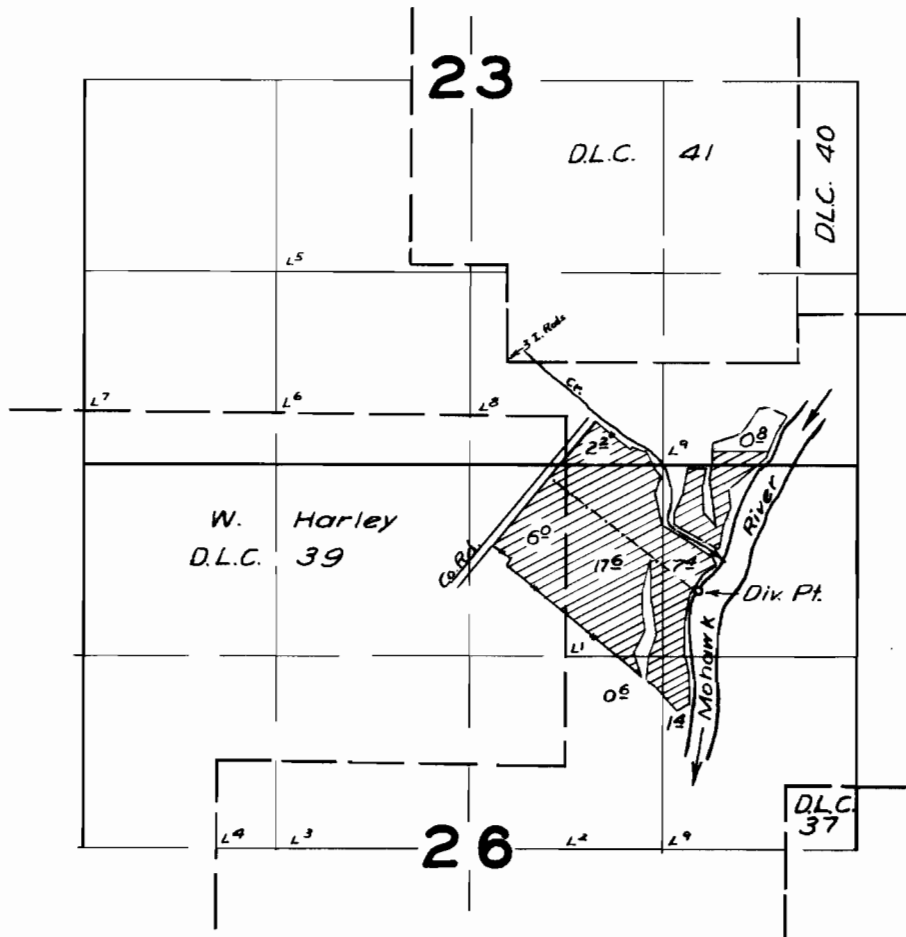

FINAL PROOF SURVEY
UNDER

Application No. 23178. Permit No. 18277.
IN NAME OF

Ernest D. Conley Jr.

Surveyed May 15, 1957, by W. B. Bish