


T.18 S.R.3 W.W.M.

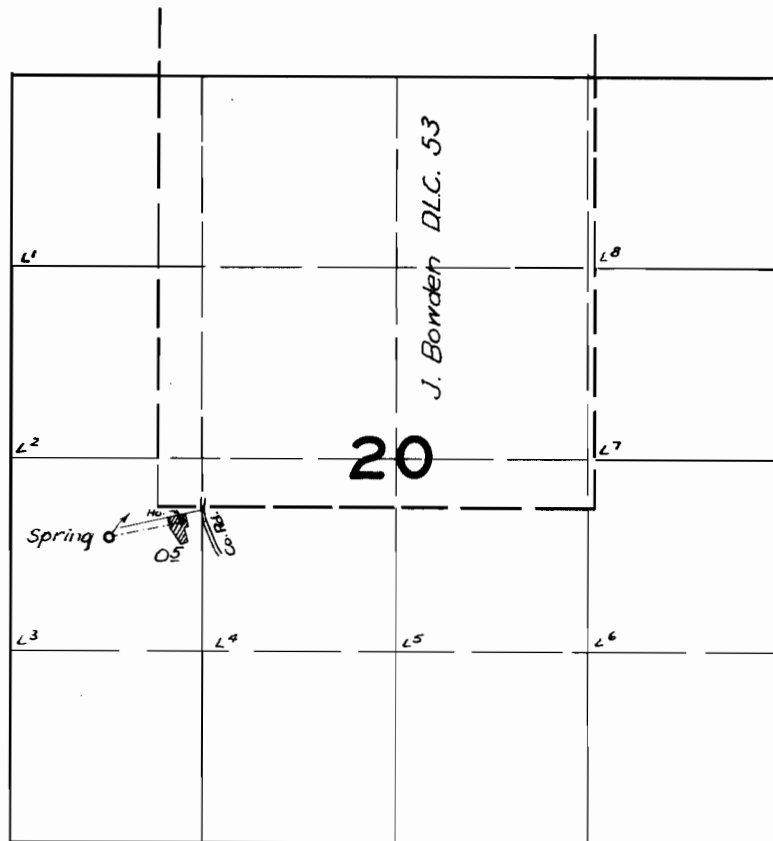

FINAL PROOF SURVEY UNDER

Application No. 23474... Permit No. 18517.....
IN NAME OF

..... *Lloyd T. Harris*

Surveyed *June 17, 1957*, by *M. Bich*.....