


T.21 S.R.3 W.W.M.

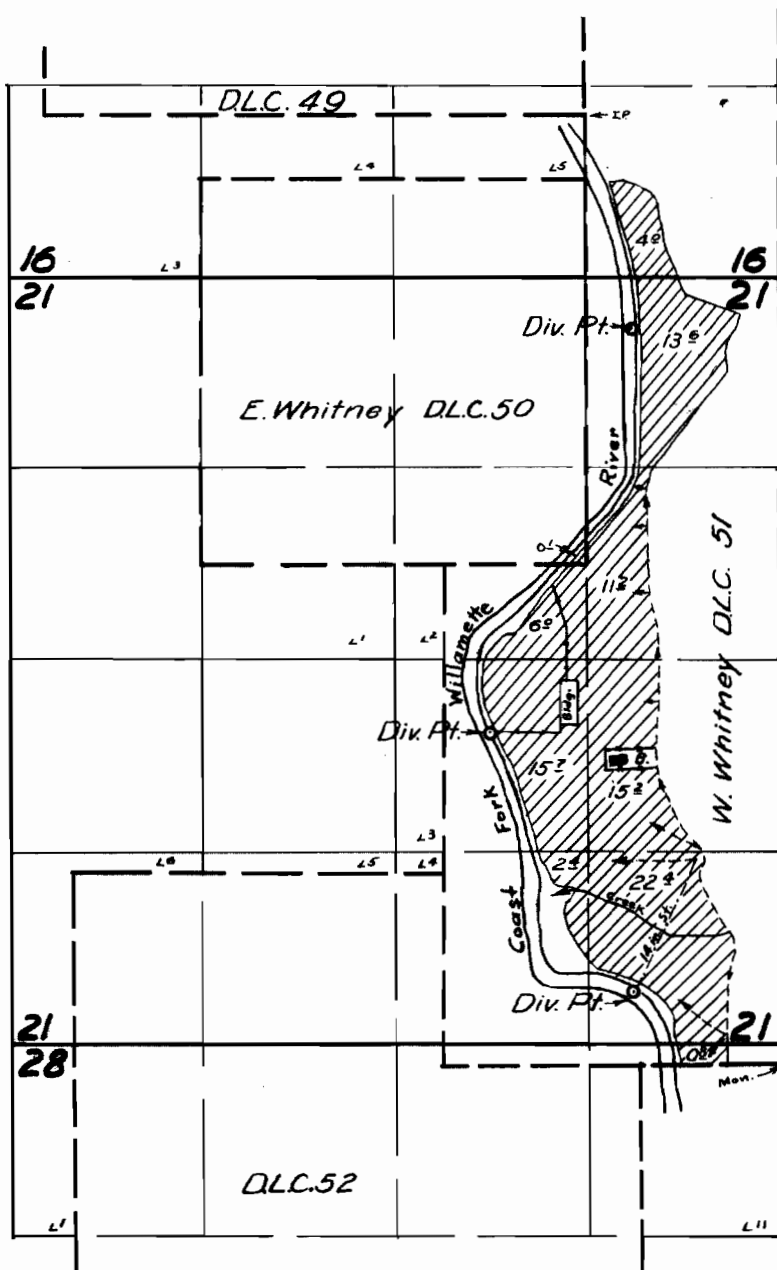

FINAL PROOF SURVEY
UNDER

Application No. 23739 Permit No. 18743
IN NAME OF

Conrad Hodge

Surveyed April 9, 1957, by Tm. Bush