


T. 7 S. R. 4 W. W. M.

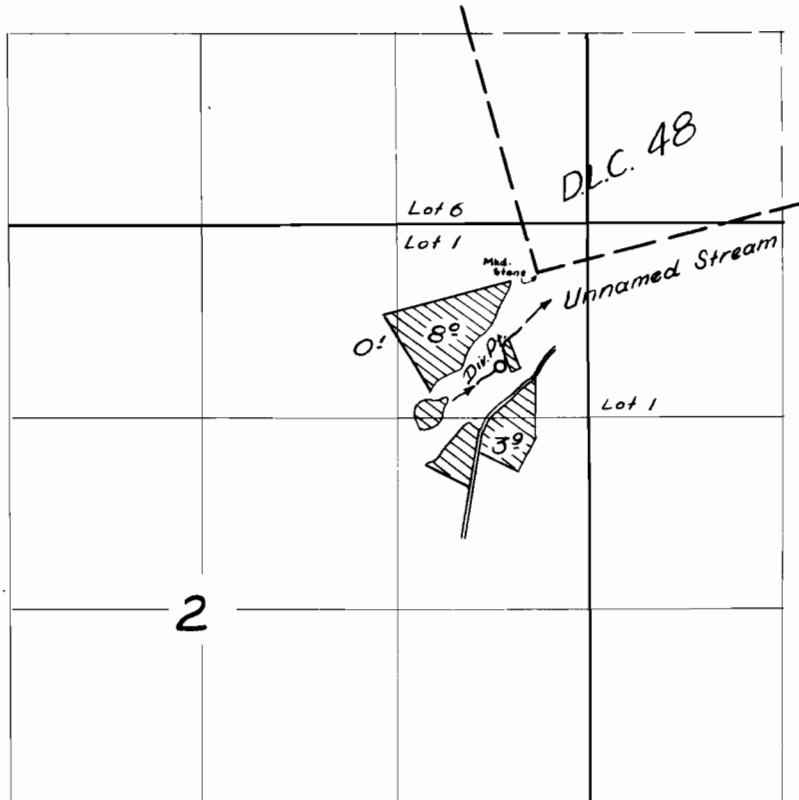

FINAL PROOF SURVEY
UNDER

Application No. 23654 Permit No. 18874
IN NAME OF

THEODORE E. BURNS

Surveyed 5 Mar. 1957, by [Signature]