


T. 15S. R. 5W. W.M.

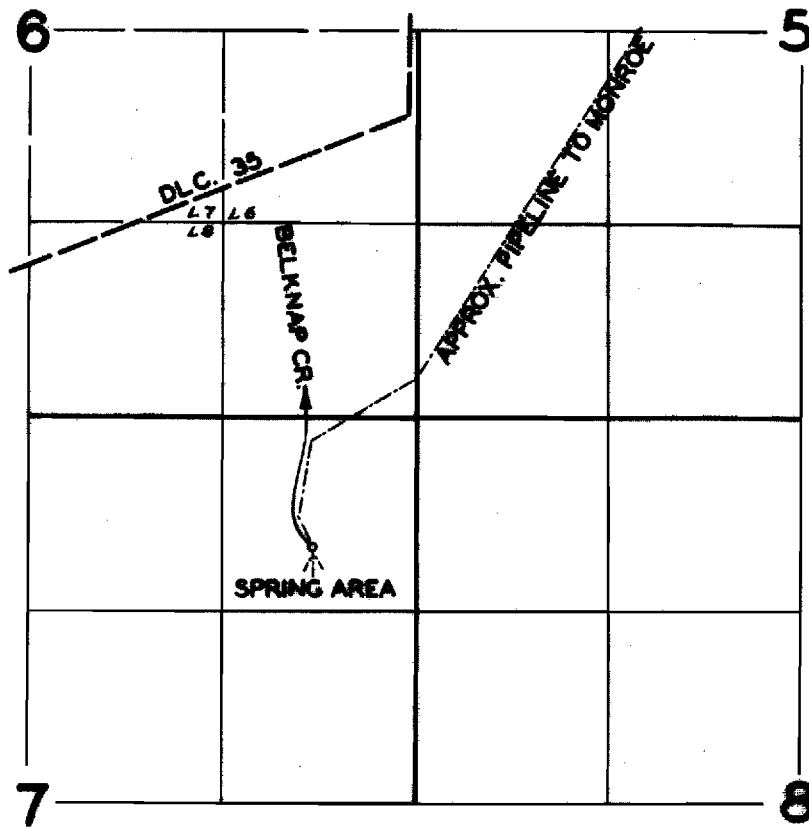

FINAL PROOF SURVEY
UNDER

Application No. 24168 Permit No. 19008
IN NAME OF

CITY OF MONROE

Surveyed SEPT. 24 1957, by *[Signature]*