


T. 19S. R. 12W. W.M.

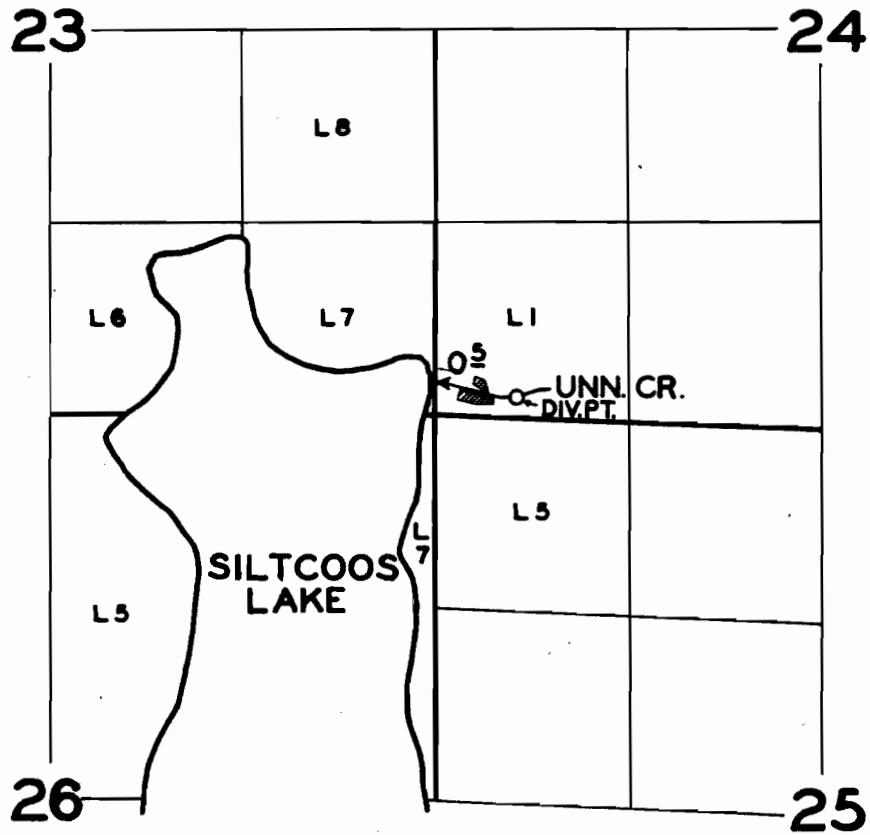

FINAL PROOF SURVEY
UNDER

Application No. 24843 Permit No. 19556
IN NAME OF

JOHN & DOROTHEA PARKER

Surveyed JUNE 12, 1957, by *[Signature]*