


T.2S. R.1 W. W.M.

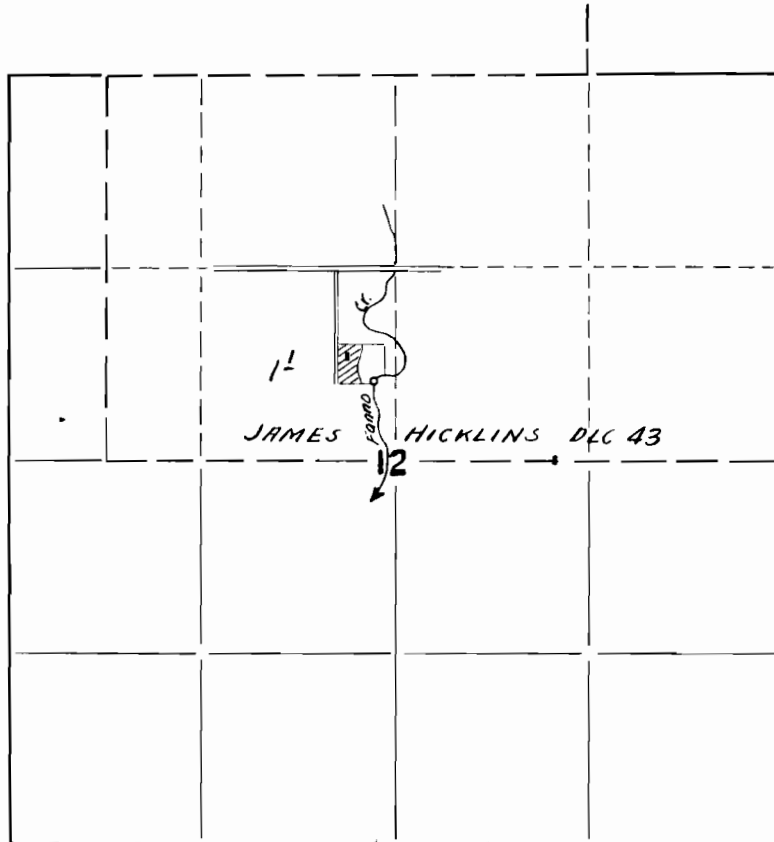

**FINAL PROOF SURVEY**

UNDER

Application No. 25121 Permit No. 19766  
IN NAME OF

ROBERT A. CAMPBELL

Surveyed 5 - 9 1956 by R. H. WHITBY